
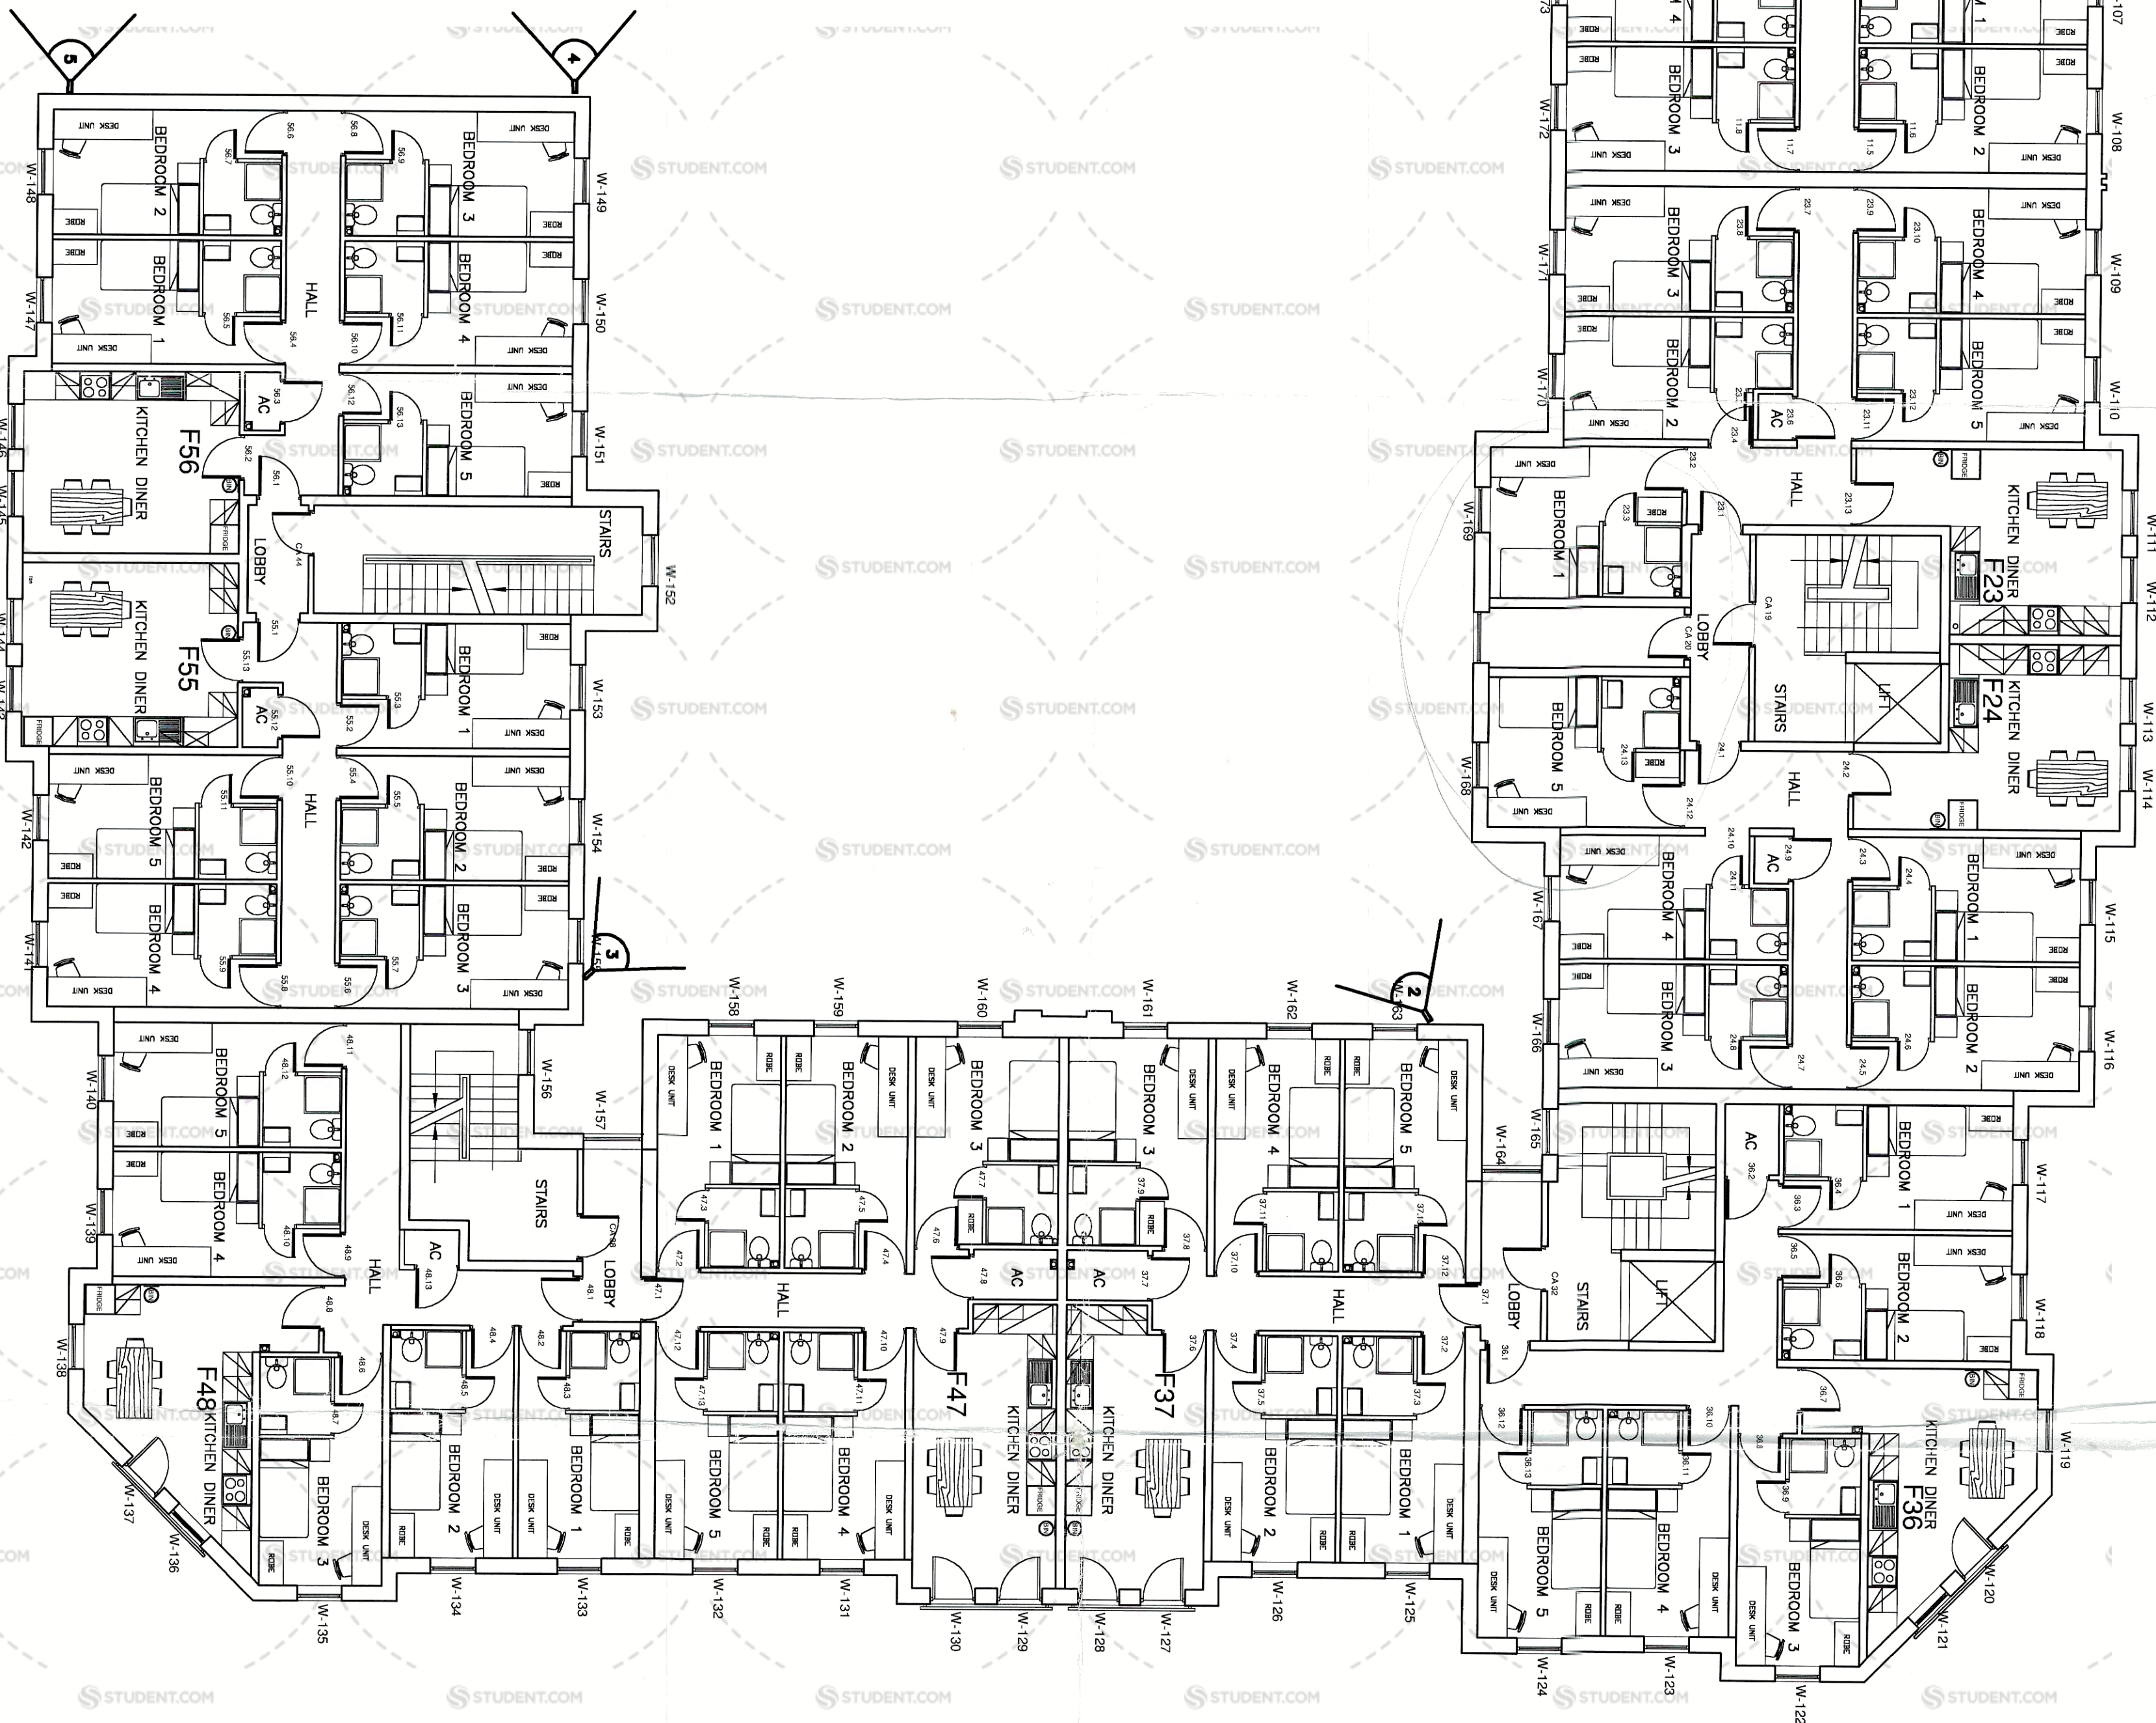


Revision	Date
----------	------

- A: General update
B: Minor amendments to windows
C: Layout revision
D: Information removed
E: Furniture and fittings amended
F: As built.
- 26.10.00
09.11.00
22.11.00
30.1.01
08.02.2001
18.09.2001

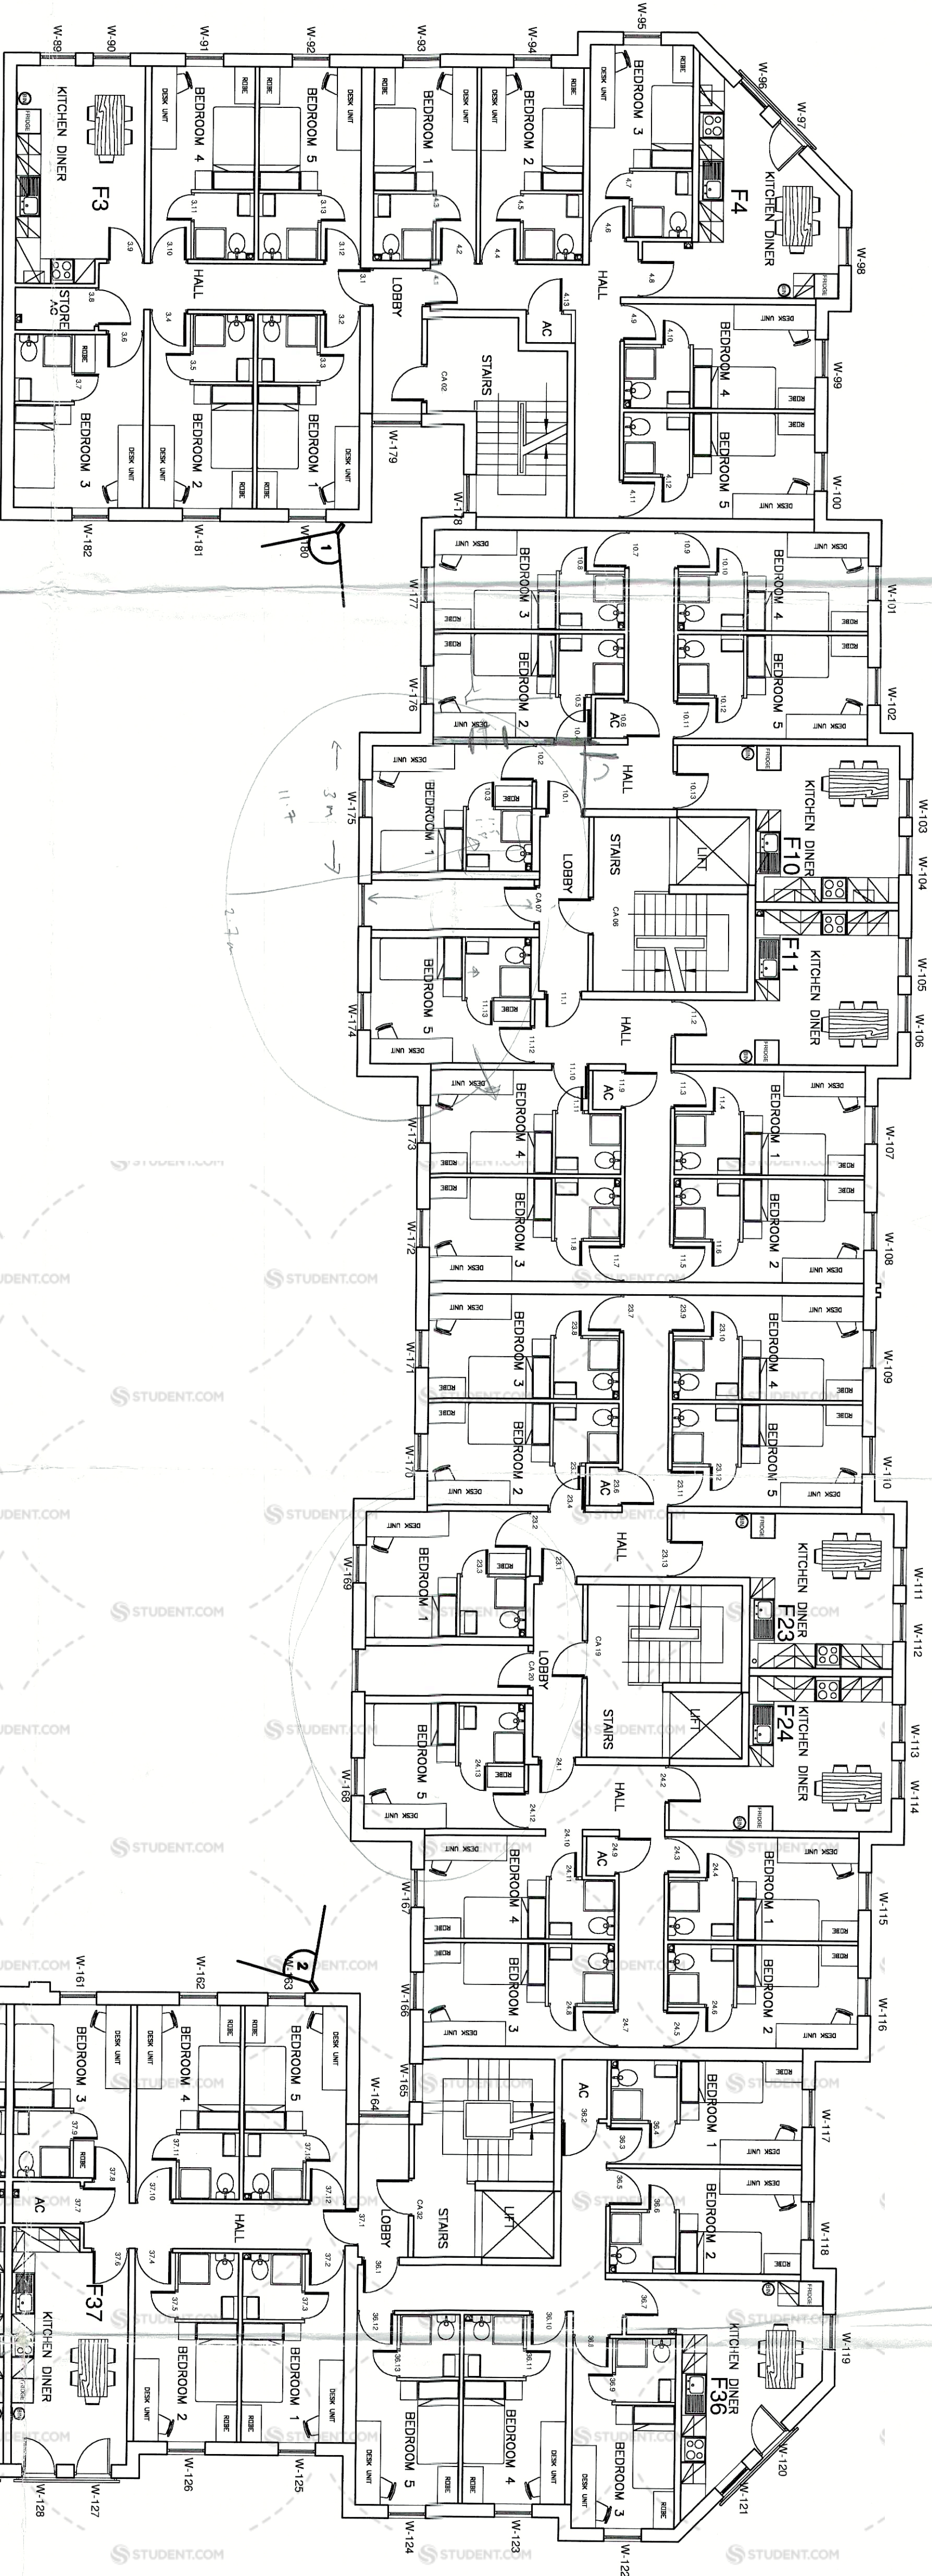

FIRST FLOOR PLAN

AS BUILT

R.G.+P.

Richard Galey & Partners
Architects, Interior Designers

The Old School, Loughborough Road
Leicester, Leicestershire LE4 5PG
Tel: (01533) 5610333 Fax: (01533) 5610678

Project PROPOSED STUDENT FLATS
FOR RIVERSIDE DEVELOPMENTS LTD
PARK STREET
LINCOLN

Title FIRST FLOOR PLAN
GENERAL ARRANGEMENT
Scale 1:100 @ A1 Ref 5043/RO/202 F
Date 25.08.2000 Drawn MK

ALL INFORMATION ON THIS DRAWING IS UNCLASSIFIED AND NOT FOR RELEASE TO THE PUBLIC. IT IS THE PROPERTY OF RIVERSIDE DEVELOPMENTS LTD AND IS NOT TO BE REPRODUCED OR TRANSMITTED IN ANY FORM OR BY ANY MEANS, ELECTRONIC OR MECHANICAL, INCLUDING PHOTOCOPYING, RECORDING, OR BY ANY INFORMATION STORAGE AND RETRIEVAL SYSTEM, WITHOUT THE WRITTEN PERMISSION OF RIVERSIDE DEVELOPMENTS LTD.