
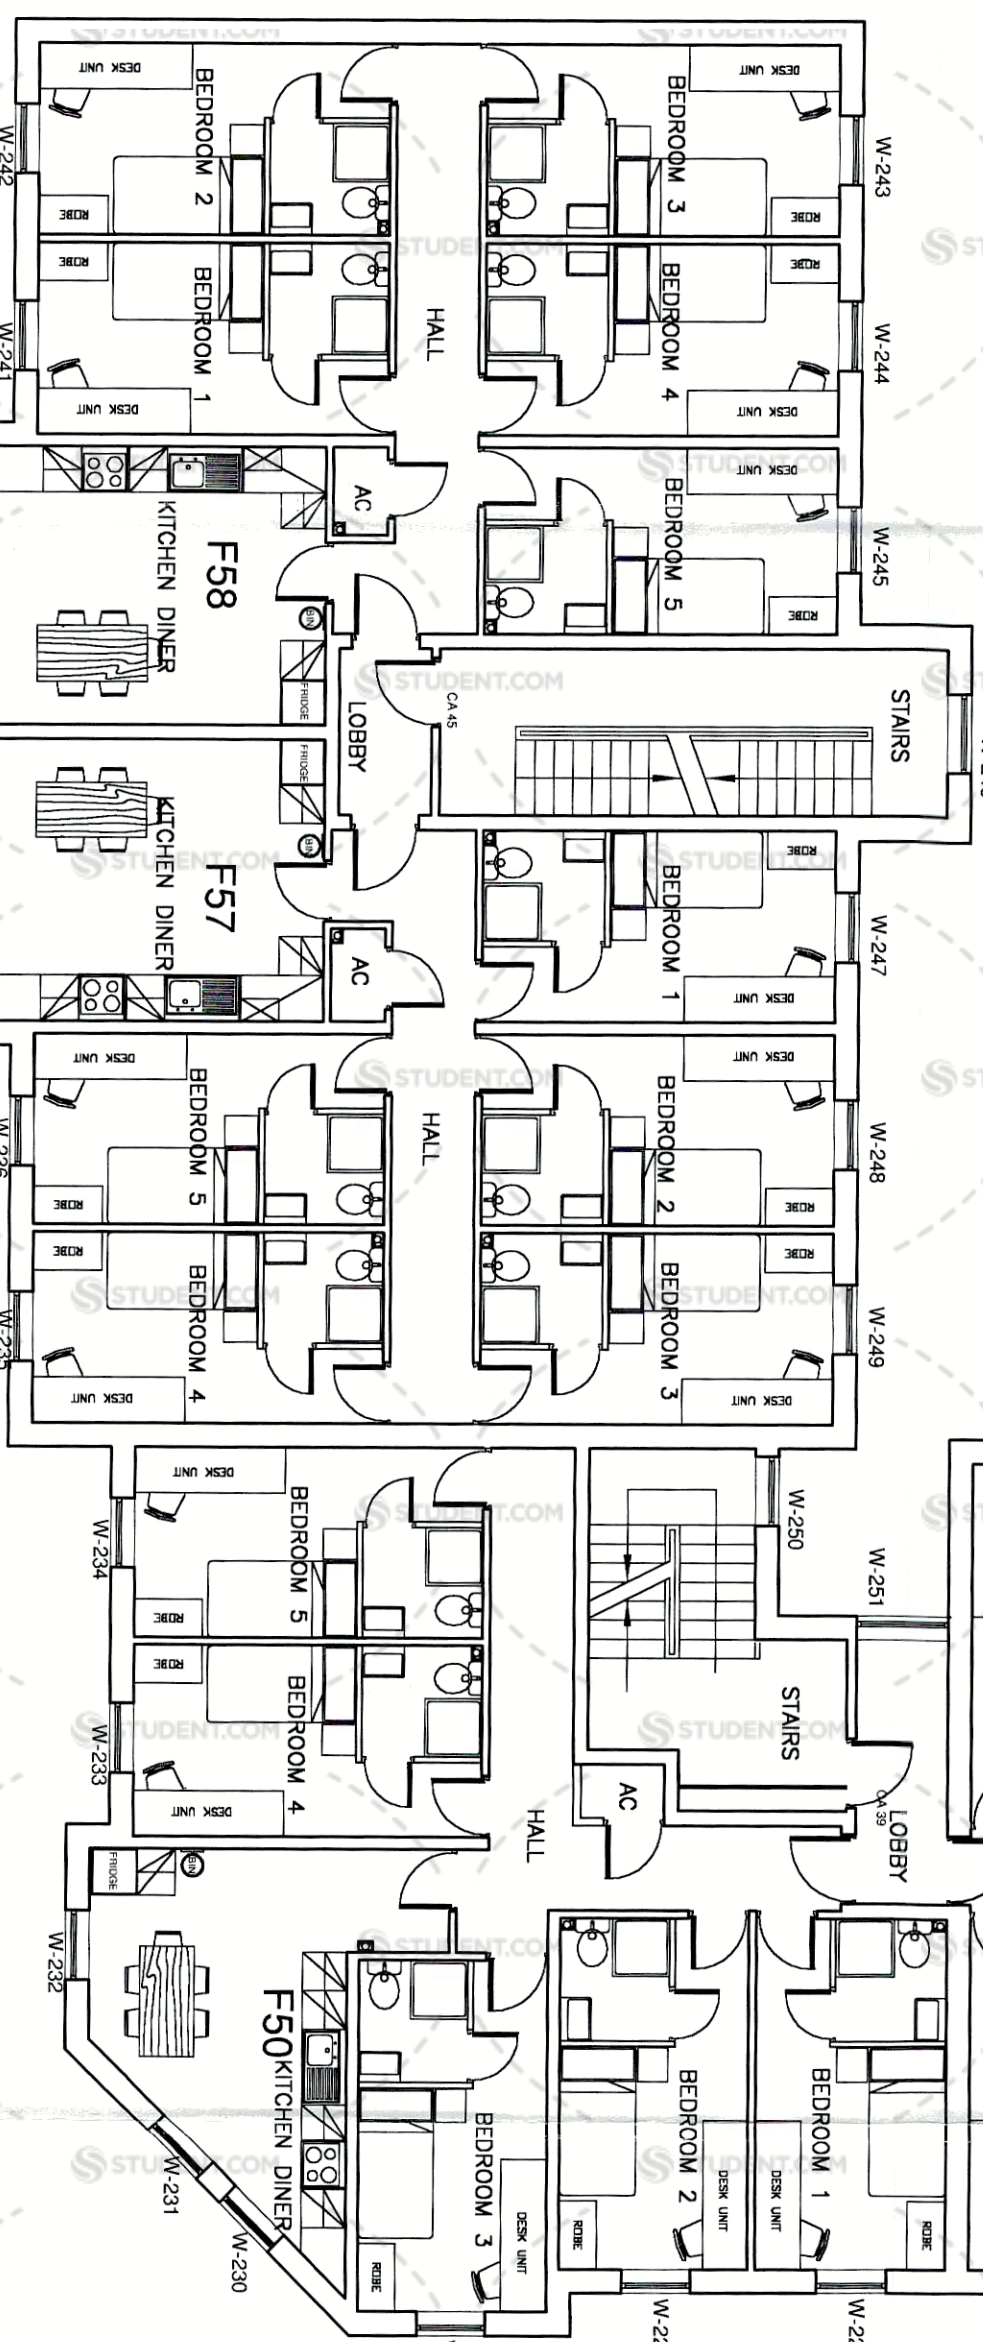


Revision	Date
A: General update	26.10.00
B: Minor amendments to windows	09.11.00
C: Layout revisions	22.11.00
D: Information removed	30.1.01
E: Furniture and fittings amended	08.02.2001
F: As built	18.09.2001

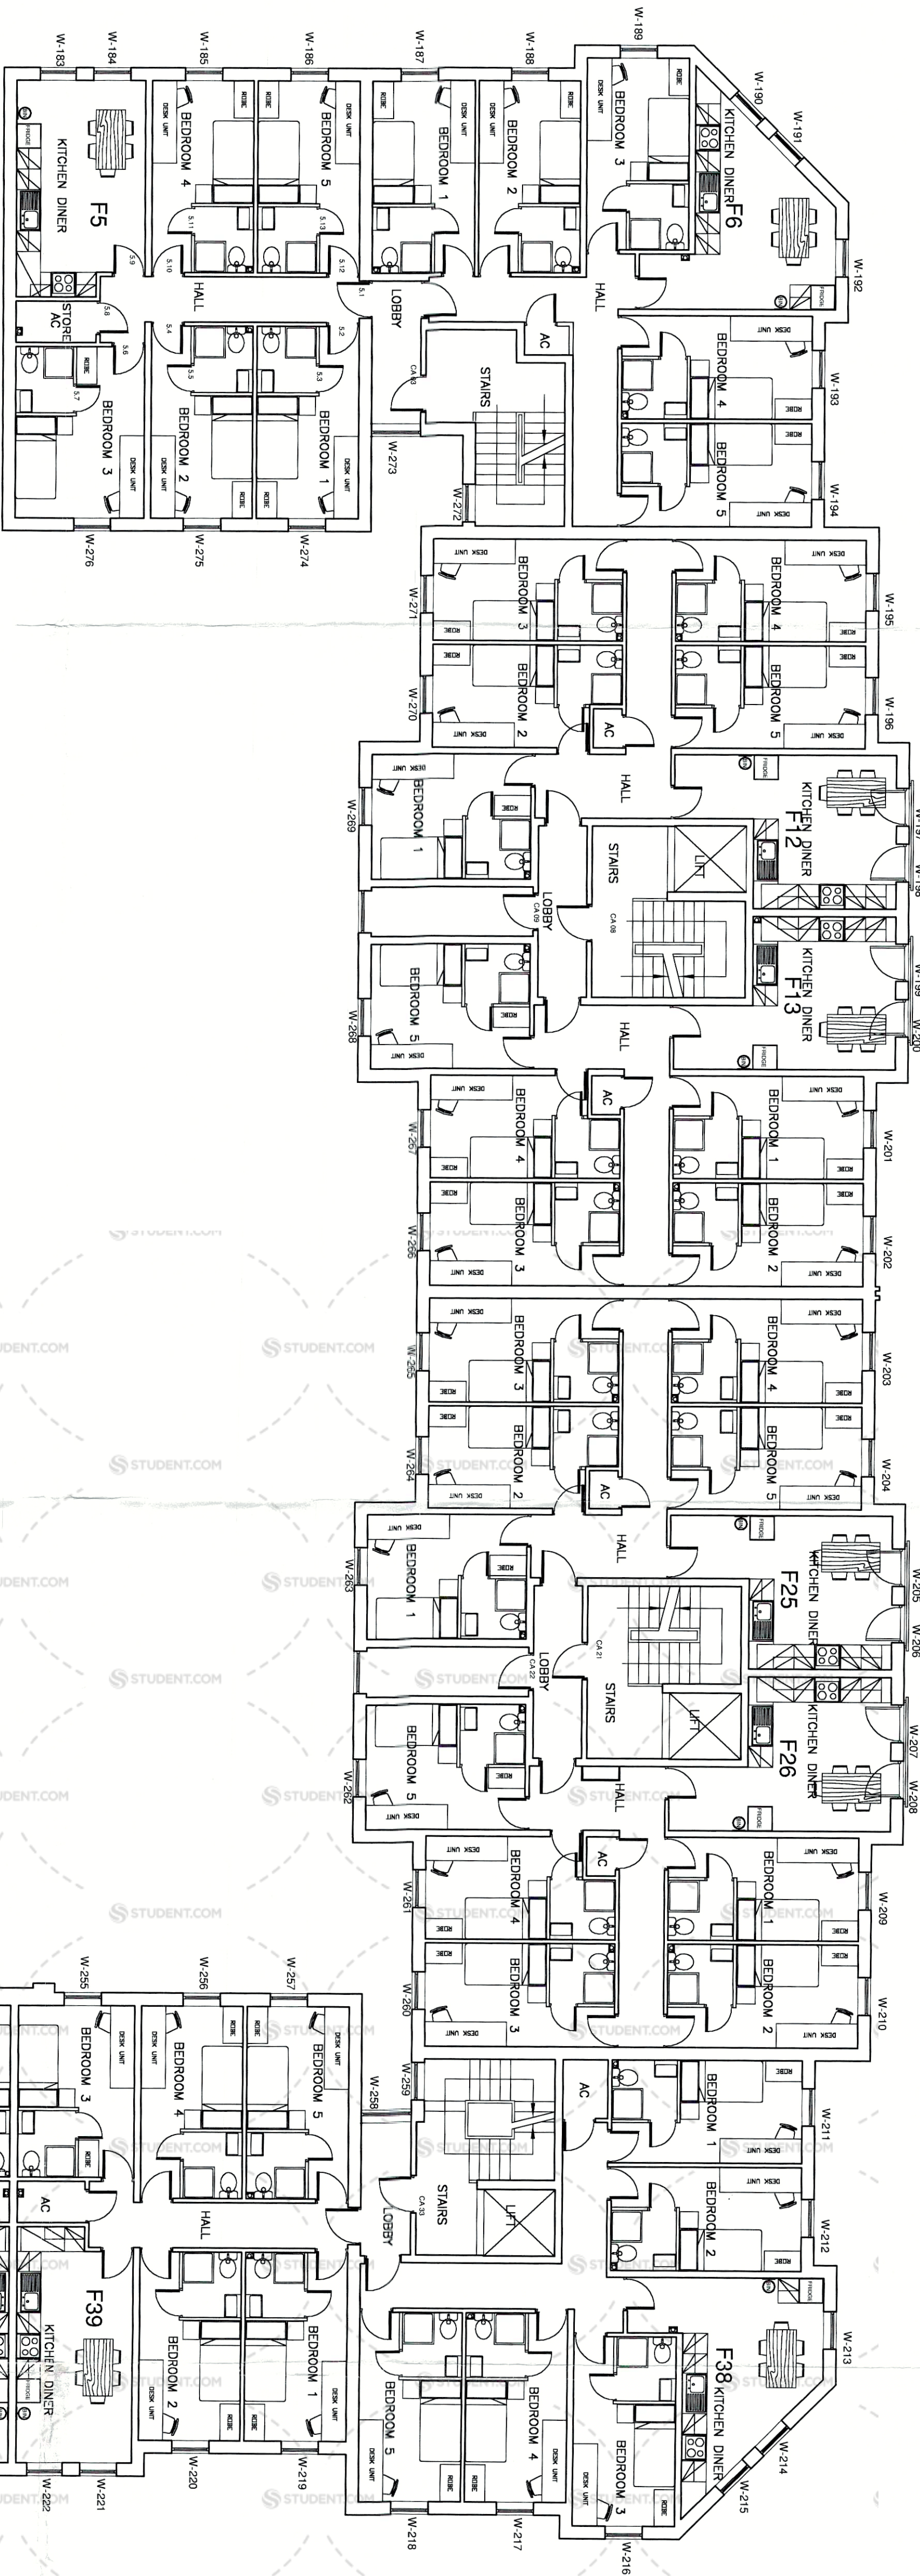

AS BUILT

R.G.+P.

Richard Galey & Partners
Architects, Interior Designers

The Old School, Loughborough Road
Lincolnshire LN6 5PG
Tel:(01533)610888 Fax:(01533)610878

Project PROPOSED STUDENT FLATS

PARK STREET

LINCOLN

FOR RIVERSIDE DEVELOPMENTS LTD

Title SECOND FLOOR PLAN

GENERAL ARRANGEMENT

Scale 1:100 @ A1 Ref 5043/PO/203 F

Date 25.09.2000 Drawn MK

SECOND FLOOR PLAN

ALL DIMENSIONS TO BE CHECKED ON SITE. NO NEW WALLS OR PARTITIONS.
THIS DRAWING IS THE PROPERTY OF THE ARCHITECT AND NOT TO BE REPRODUCED OR
FOR ANY OTHER PURPOSE WITHOUT THE WRITTEN PERMISSION OF RICHARD GALEY & PARTNERS.