

Revision	Date
----------	------

- A: General update

26.10.00
- B: Minor amendments to windows

09.11.00
- C: Layout revisions

22.11.00
- D: Information removed

30.1.01
- E: Furniture and fittings amended

08.02.2001
- F: As built.

18.09.2001

AS BUILT

R.G+P.

Richard Galey & Partners
Architects, Interior Designers


The Old School, Loughborough Road
Leicester, Leicestershire LE4 5PG
Tel:(0116)2610333 Fax:(0116)2610678

Project PROPOSED STUDENT FLATS
PARK STREET
LINCOLN
FOR
RIVERSIDE DEVELOPMENTS LTD

Title THIRD FLOOR PLAN
GENERAL ARRANGEMENT

Scale 1:100 @ A1 Ref 5043/RD/204 F
Date 25.09.2000 Drawn MK

NOT TO SCALE
ALL DIMENSIONS TO BE CHECKED ON SITE. DO NOT SCALE OFF DRAWING.
THIS DRAWING IS THE PROPERTY OF R.G+P. AND IS NOT TO BE REPRODUCED OR
TRANSMITTED IN ANY FORM OR BY ANY MEANS, WITHOUT THE WRITTEN
PERMISSION OF RICHARD GALEY & PARTNERS.

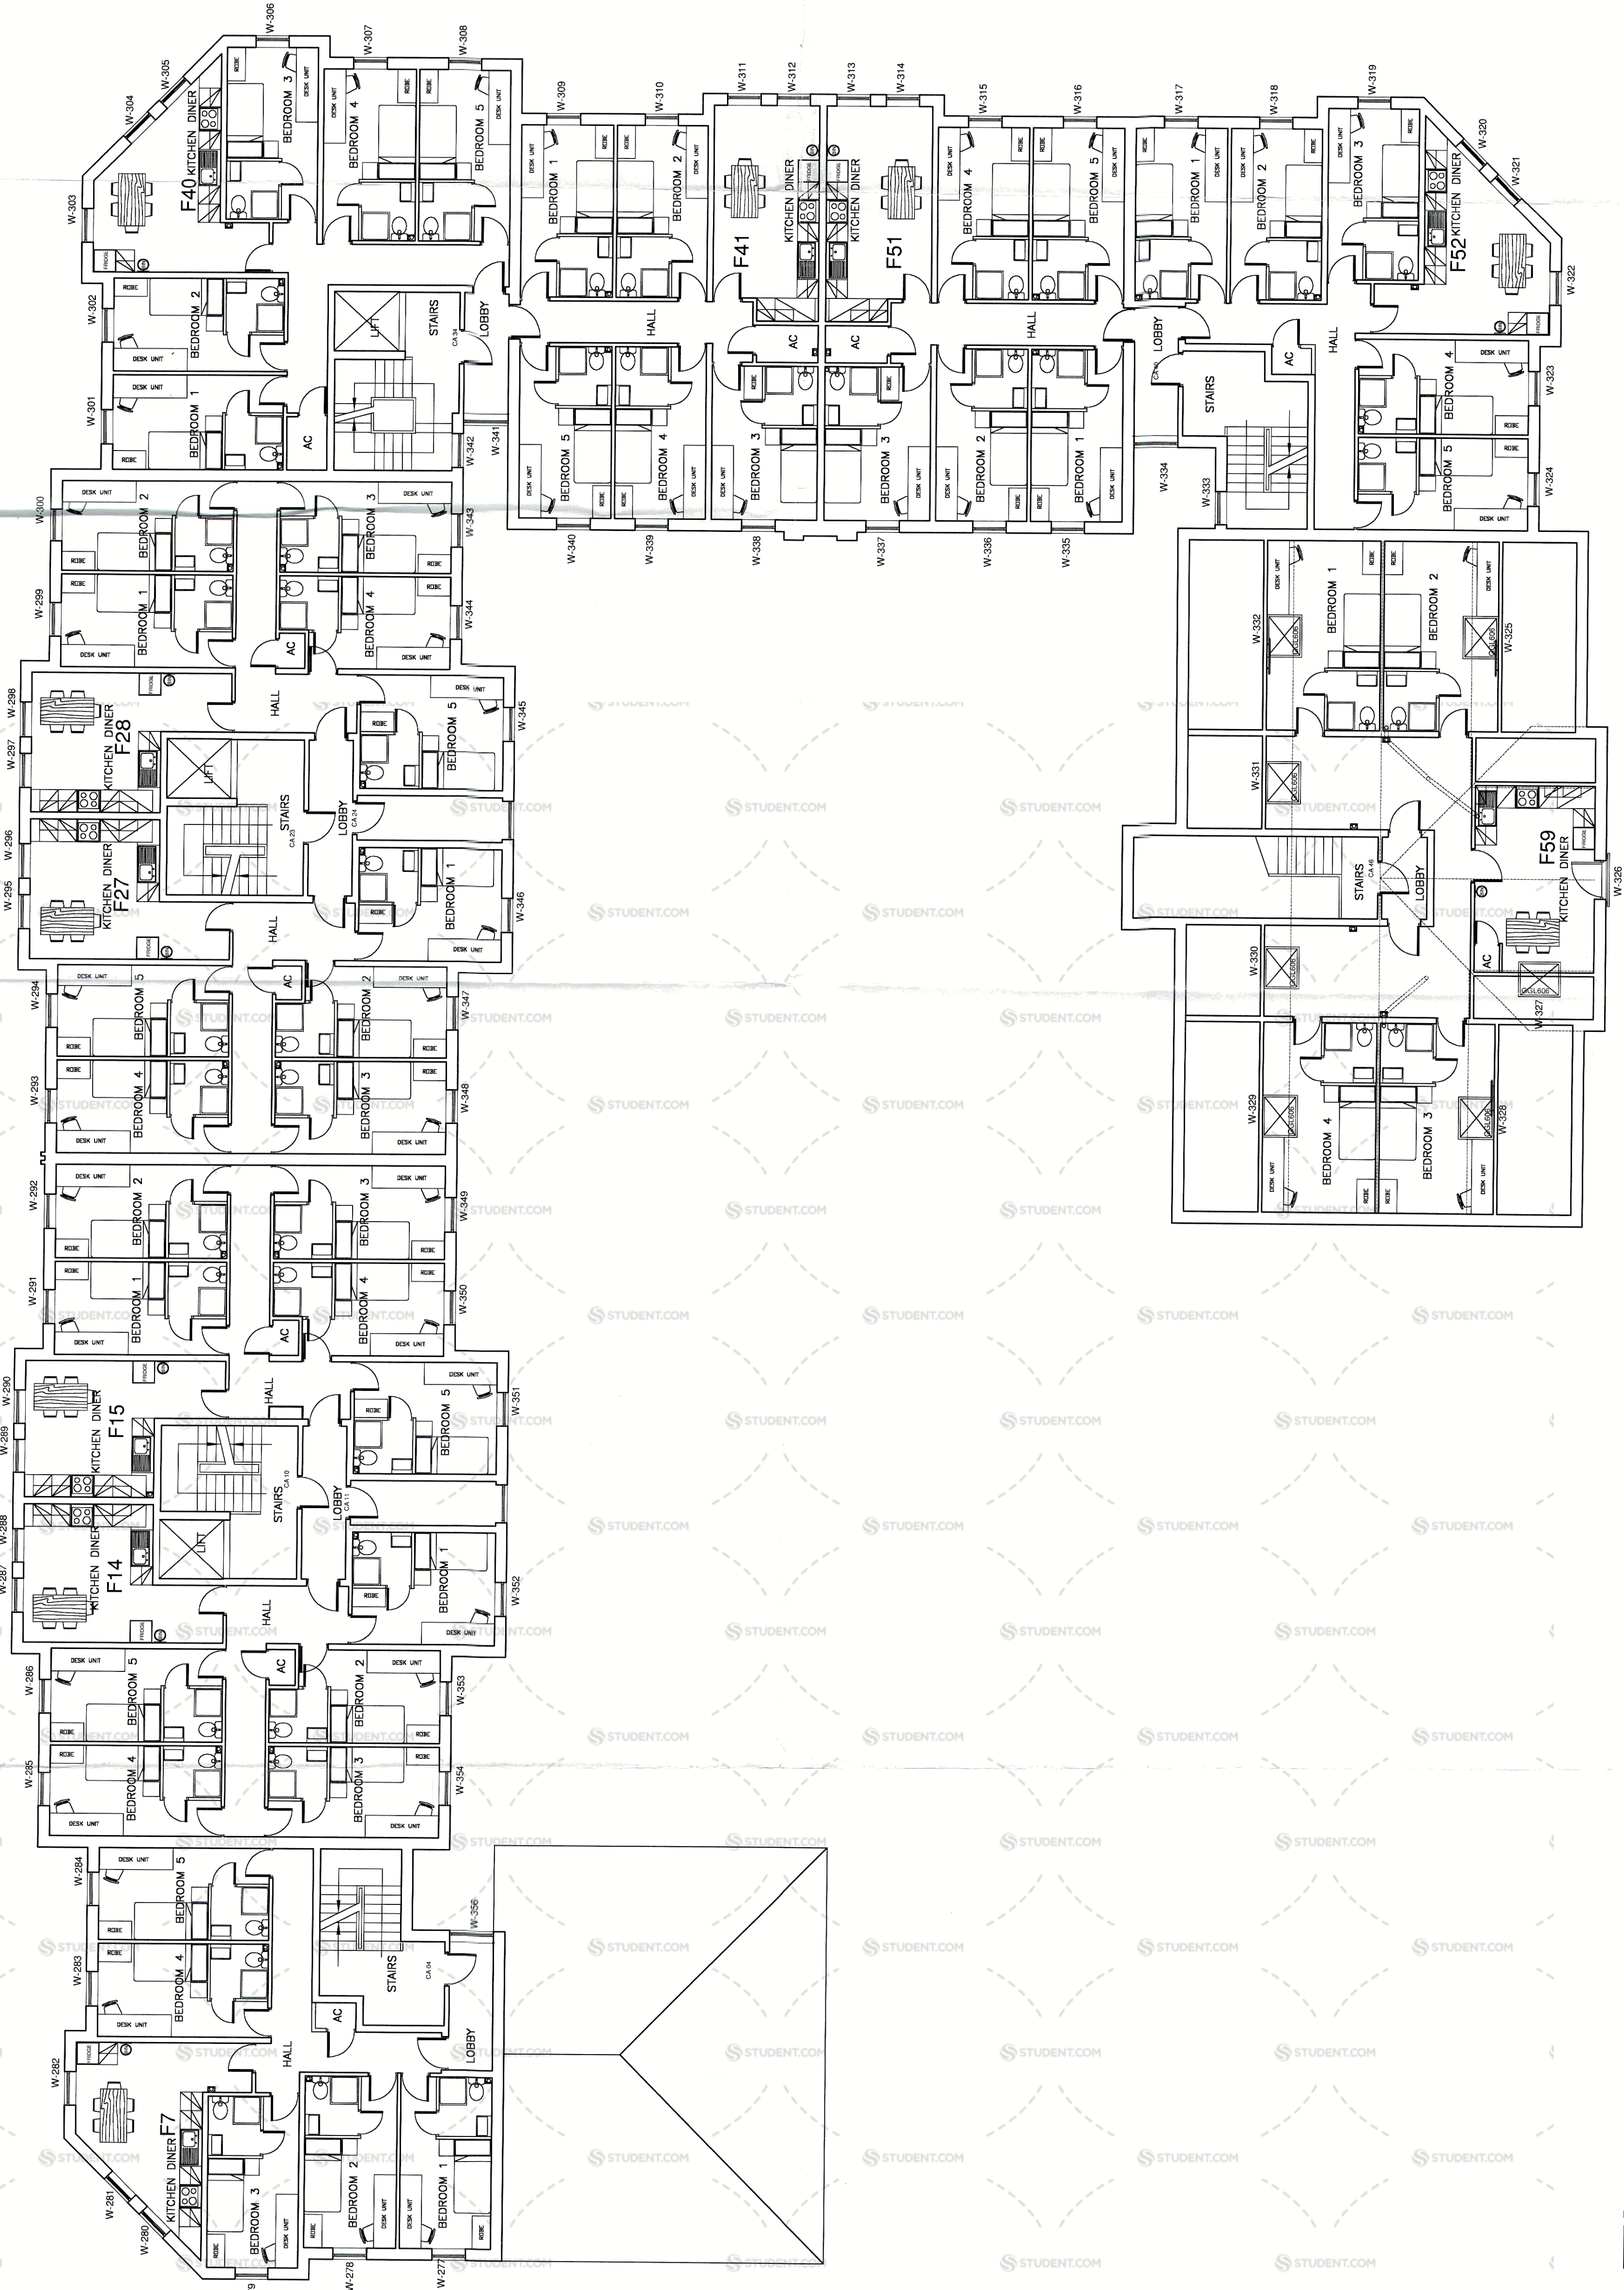

THIRD FLOOR PLAN