

Revision	Date
A: GENERAL UPDATE	23.10.2000
B: GENERAL UPDATE	28.10.2000
C: MINOR AMENDMENTS TO WINDOWS	09.11.2000
D: Windows to courtyard amended minor setting out adjustment only	25.11.2000
E: Information removed	30.1.01
F: Furniture and fittings amended	08.02.2001
G: As built.	18.09.2001

AS BUILT

R.G+P.


Richard Galey & Partners
Architects, Interior Designers

The Old School, Loughborough Road
Leicester, Leicestershire LE4 5PG
Tel:(0116)2610383 Fax:(0116)2610878

Project PROPOSED STUDENT FLATS
PARK STREET
LINCOLN
FOR
RIVERSIDE DEVELOPMENTS LTD

Title FOURTH FLOOR PLAN
GENERAL ARRANGEMENT
Scale 1:100 @ A1 Ref 5043/R0/205 G
Date 25.09.2000 Drawn MK

ALL DIMENSIONS IN MM. UNLESS OTHERWISE STATED. THIS DRAWING IS THE PROPERTY OF R.G+P. AND NOT BE LOANED, COPIED, REPRODUCED OR USED IN ANY MANNER WITHOUT THE WRITTEN PERMISSION OF R.G+P. COPYRIGHT RESERVED.

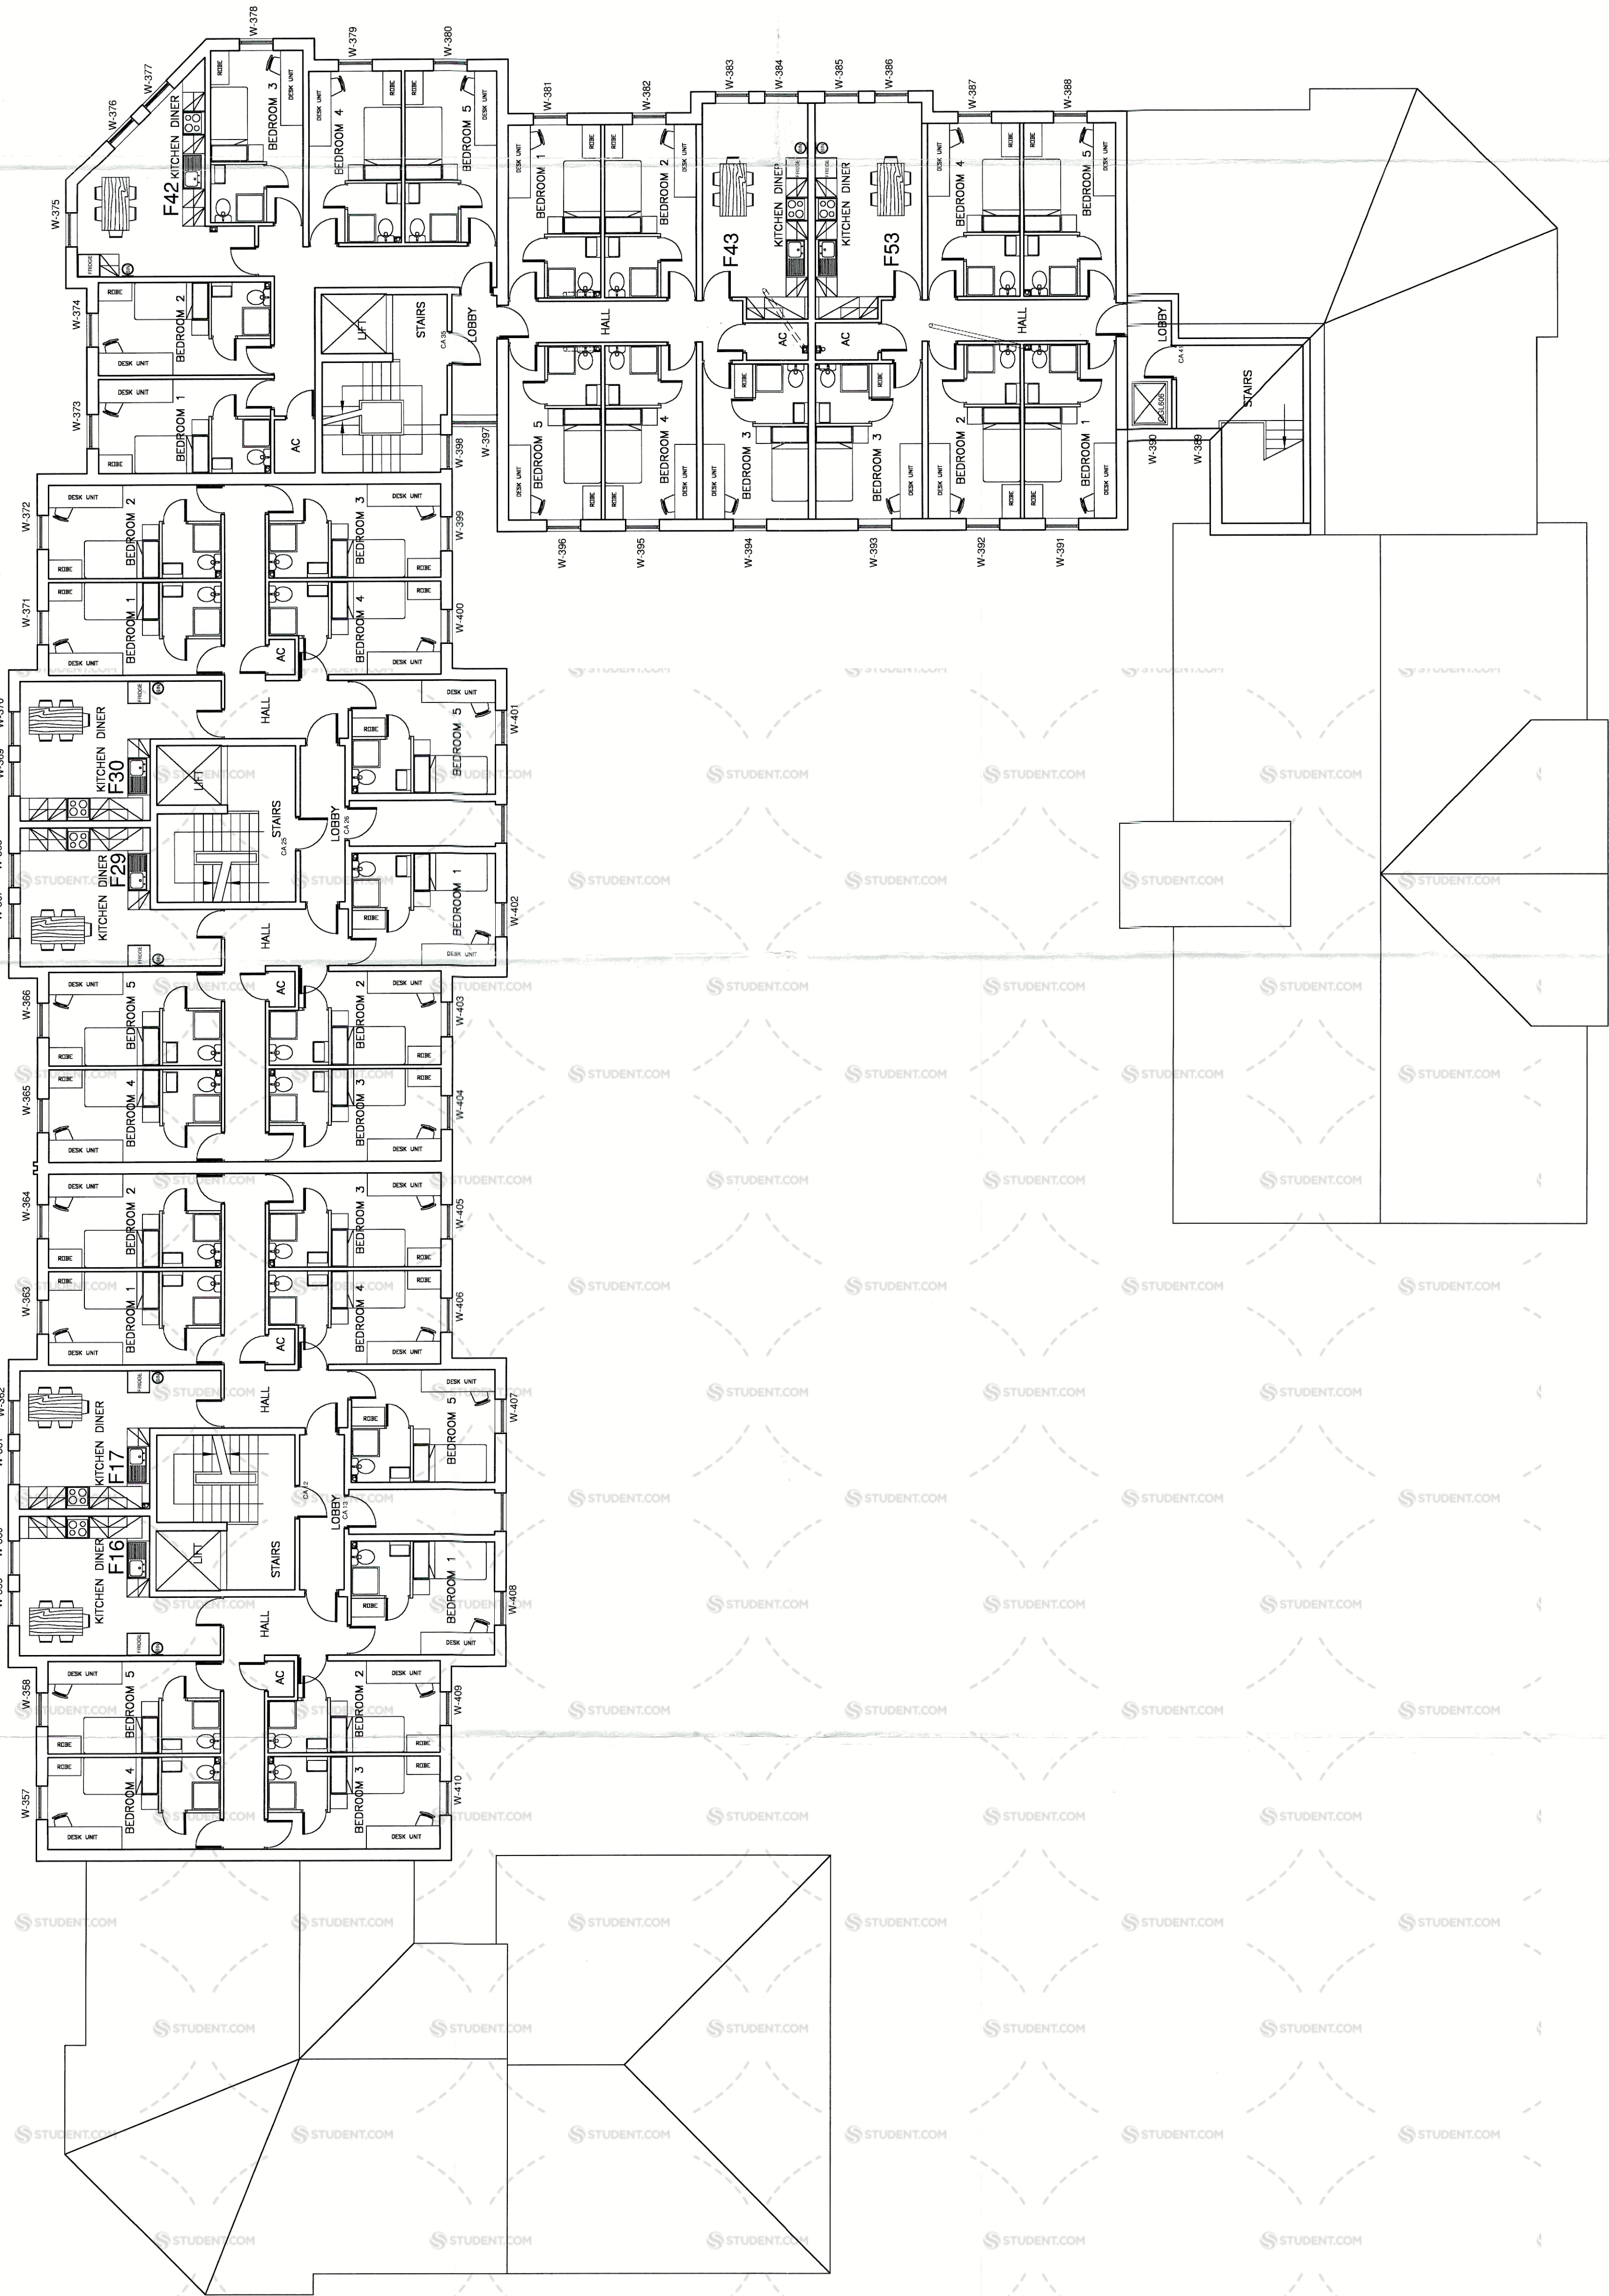

FOURTH FLOOR PLAN