



Revision	Date
A: GENERAL UPDATE	23.10.2000
B: GENERAL UPDATE	26.10.2000
C: MINOR AMENDMENTS TO WINDOWS	09.11.2000
D: Door swings amended	25.11.2000
E: Information removed	30.1.01
F: Furniture and fittings amended	08.02.2001
G: 6th Floor RH flat re numbered F33(not F20)	06.04.2001
H: As built	18.09.2001

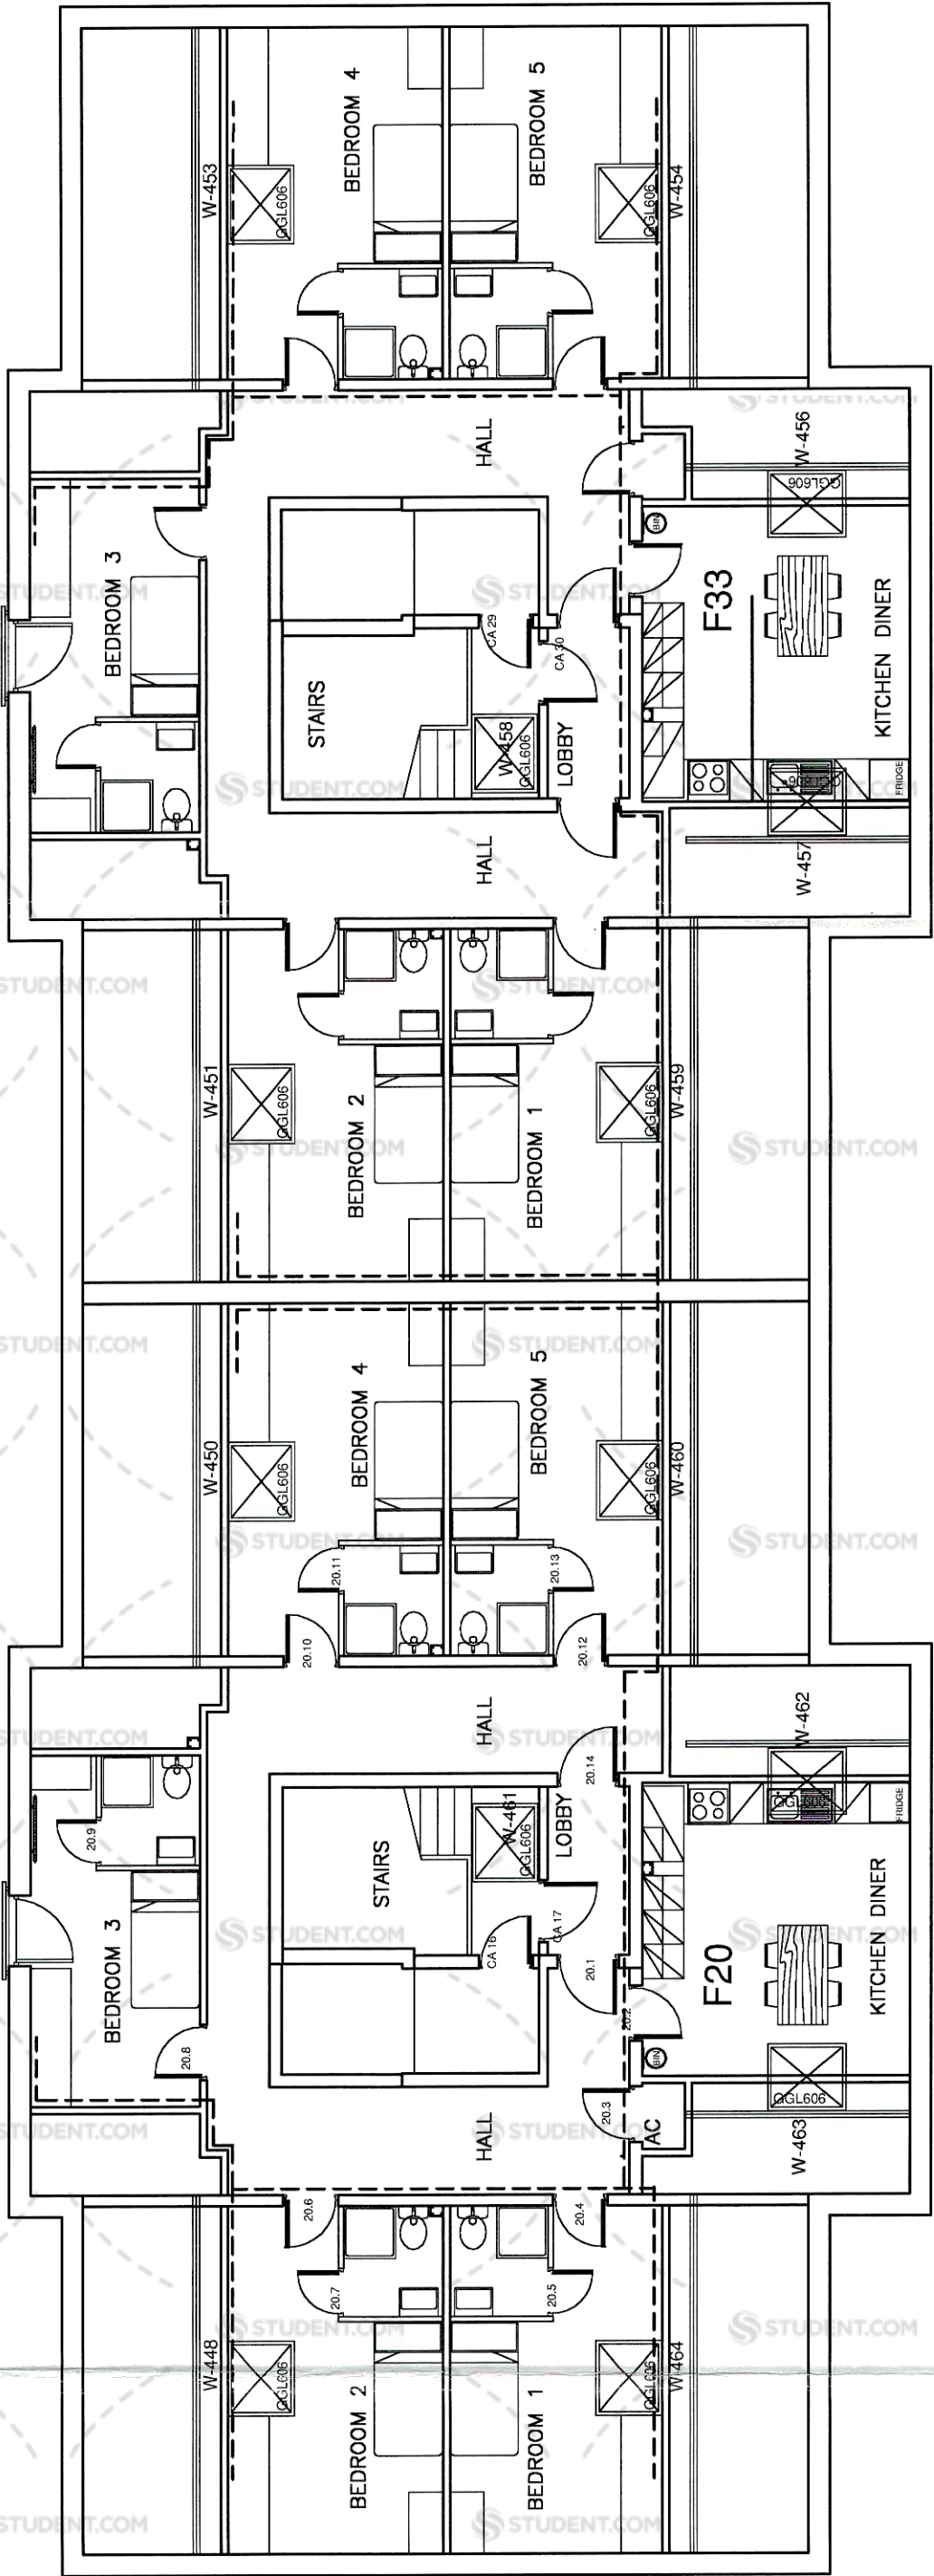

SIXTH FLOOR PLAN

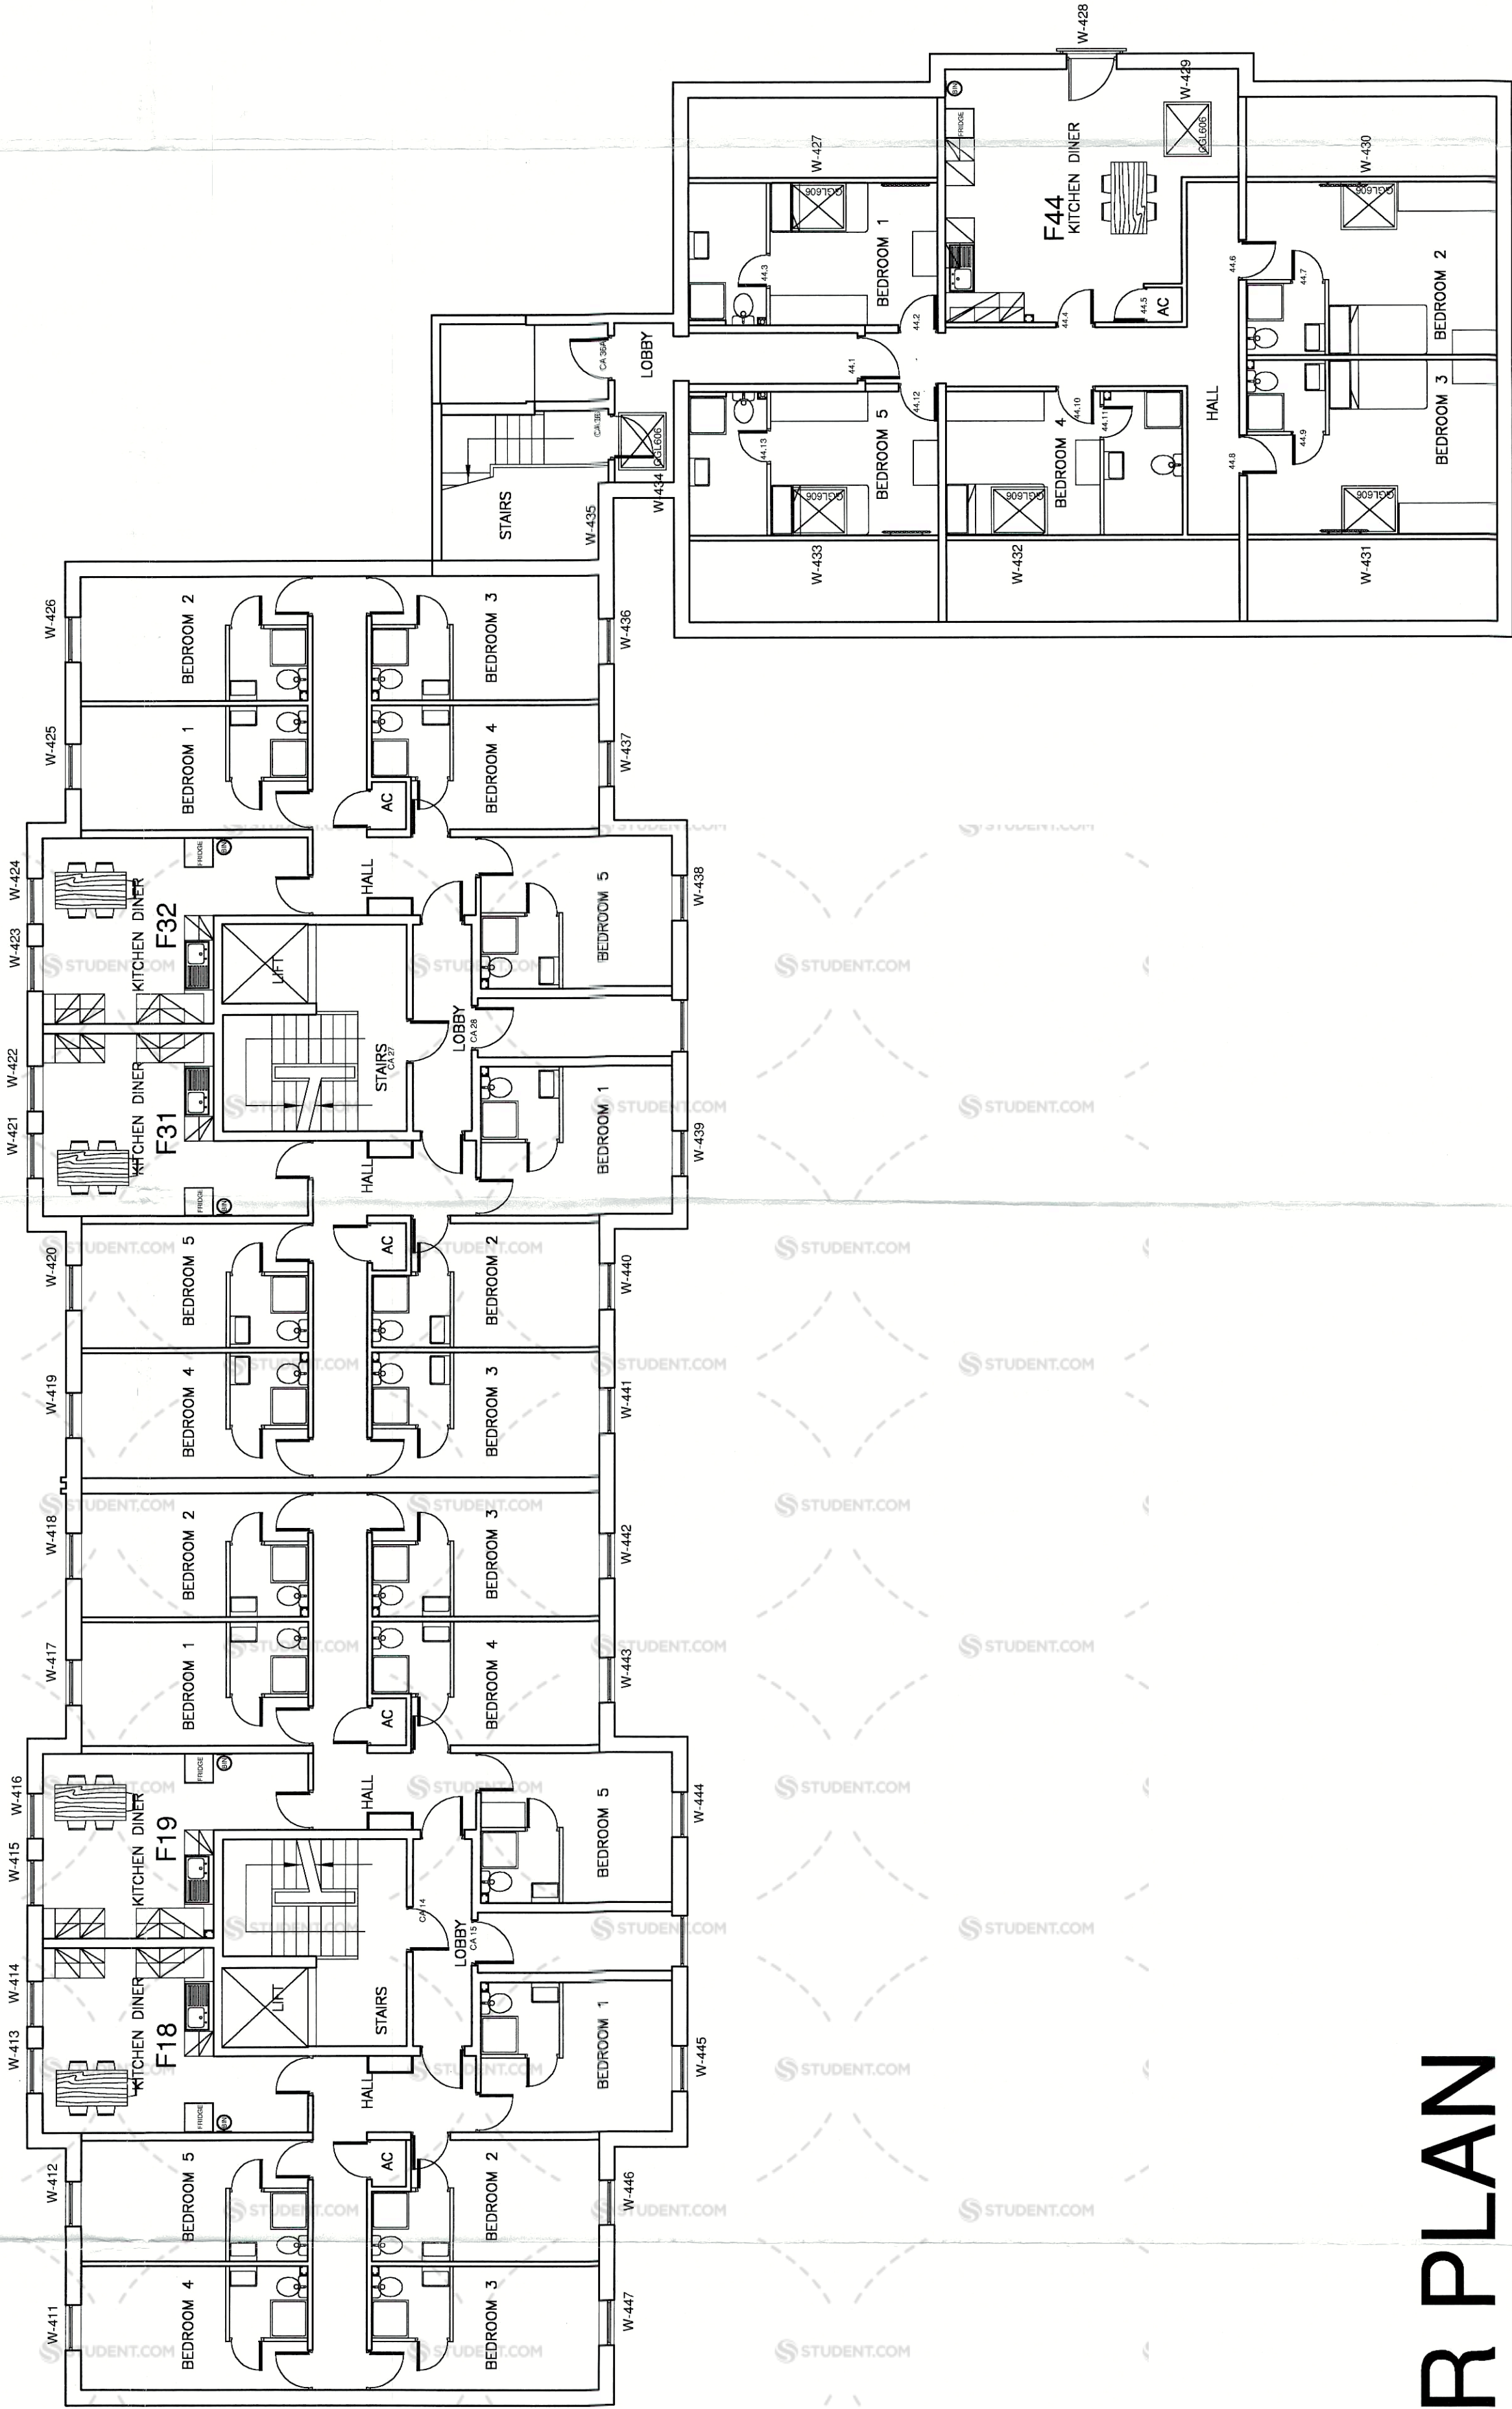

FIFTH FLOOR PLAN

AS BUILT

R.G+P.

Richard Galey & Partners
Architects, Interior Designers

The Old School, Loughborough Road
Leicester LE1 1JH
Tel: (0116) 2010353 Fax: (0116) 2610878

Project PROPOSED STUDENT FLATS
Park Street
Lincoln
FOR RIVERSIDE DEVELOPMENTS LTD

Title FIFTH & SIXTH FLOOR PLANS
GENERAL ARRANGEMENT
Scale 1:100 @ A1 Ref 5043/RD/206 H
Date 25.09.2000 Drawn MK

ALL DIMENSIONS TO FACE UNLESS STATED OTHERWISE
THIS DRAWING IS THE PROPERTY OF THE ARCHITECT AND NOT TO BE REPRODUCED
WITHOUT THEIR WRITTEN PERMISSION. COPYRIGHT RESERVED.