


Revision	Date
----------	------

- A: General update 26:10:00
- B: Minor amendments to windows 09:11:00
- C: Layout revision 22:11:00
- D: Information removed 30:1:01
- E: Furniture and fittings amended 08.02.2001
- F: As built. 18.09.2001

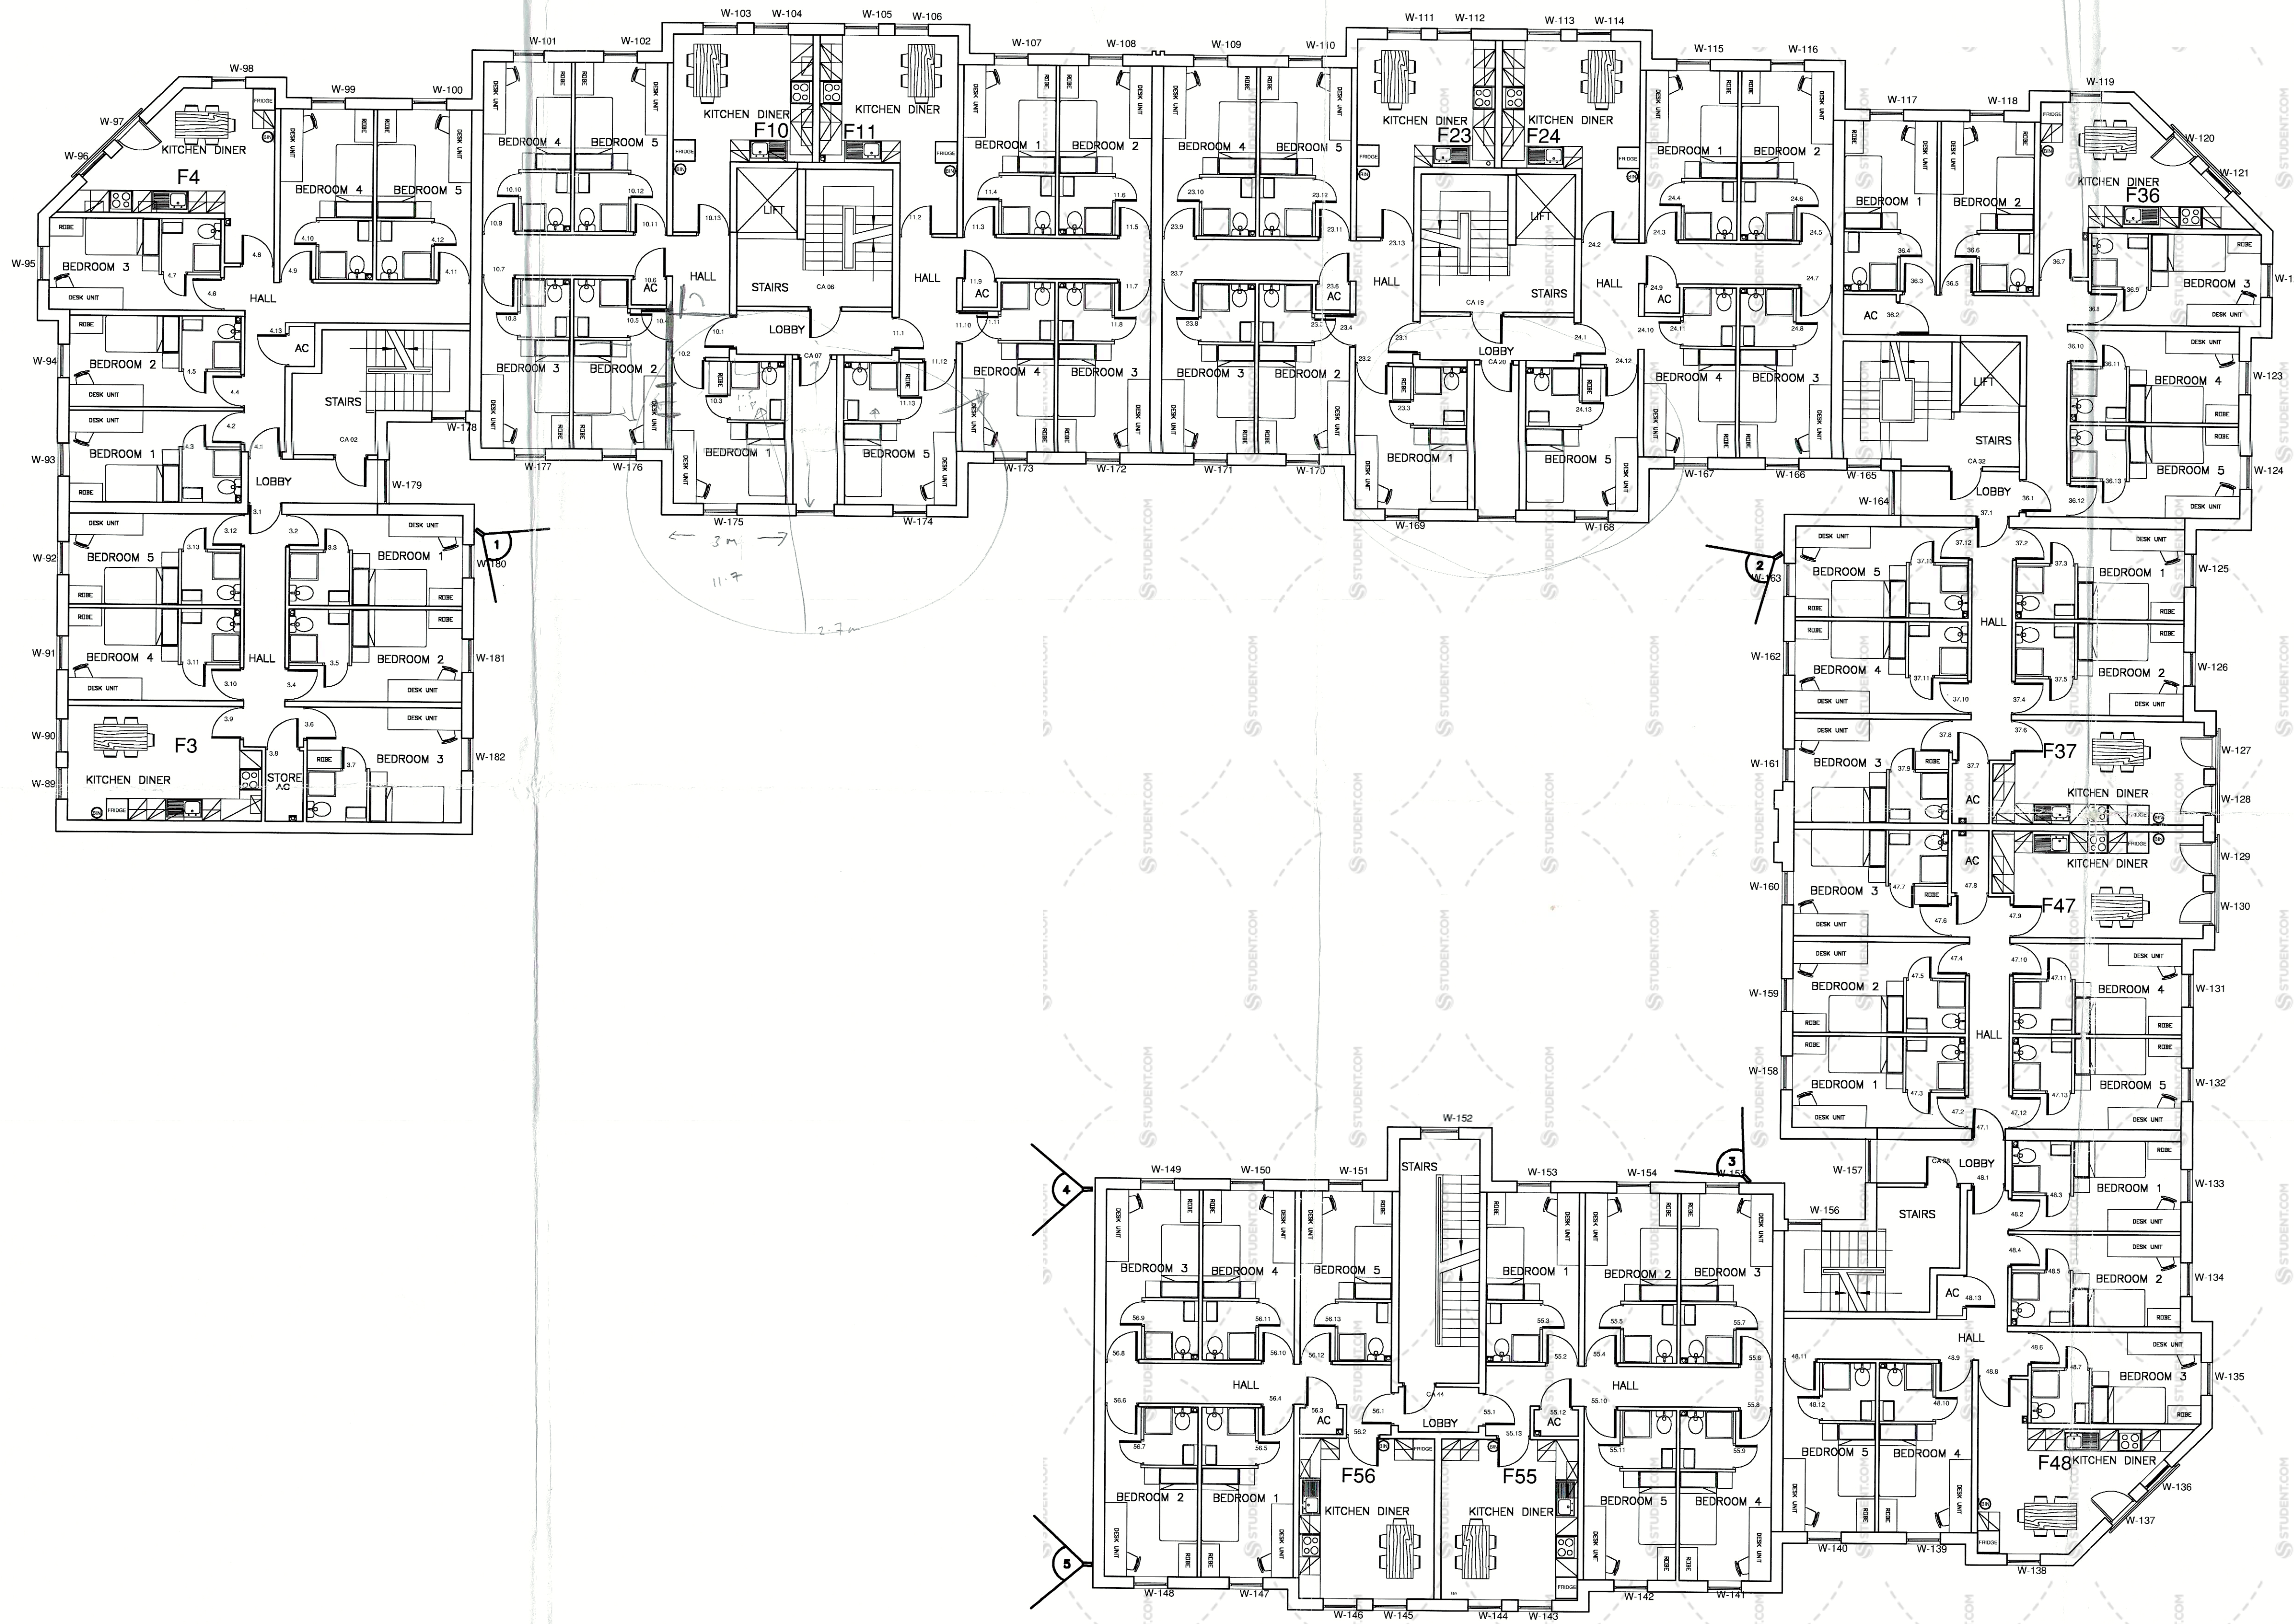

AS BUILT

R.G+P.

Richard Galey & Partners
Architects, Interior Designers

The Old School, Loughborough Road
Leicester, Leicestershire LE4 5PG
Tel:(0116)2610933 Fax:(0116)2610678

Project PROPOSED STUDENT FLATS
PARK STREET
LINCOLN
FOR
RIVERSIDE DEVELOPMENTS LTD

Title FIRST FLOOR PLAN
GENERAL ARRANGEMENT

Scale 1:100 @ A1 Ref 5043/RD/202 F

Date 25.09.2000 Drawn MK

ALL DIMENSIONS TO BE CHECKED ON SITE. DO NOT SCALE OFF DRAWING.
THIS DRAWING IS THE COPYRIGHT OF THE ARCHITECT AND NOT TO BE REPRODUCED
WITHOUT THEIR PERMISSION. ORIGINATOR'S LIABILITY FOR INFORMATION REPRODUCED WITH
PERMISSION OF THEIR CLIENTS IS NOT ACCEPTED.

FIRST FLOOR PLAN