


Revision	Date
A: GENERAL UPDATE	23.10.2000
B: GENERAL UPDATE	26.10.2000
C: MINOR AMENDMENTS TO WINDOWS	09.11.2000
D: Windows to courtyard amended minor setting out adjustment only	25.11.2000
E: Information removed	30.1.01
F: Furniture and fittings amended	08.02.2001
G: As built.	18.09.2001

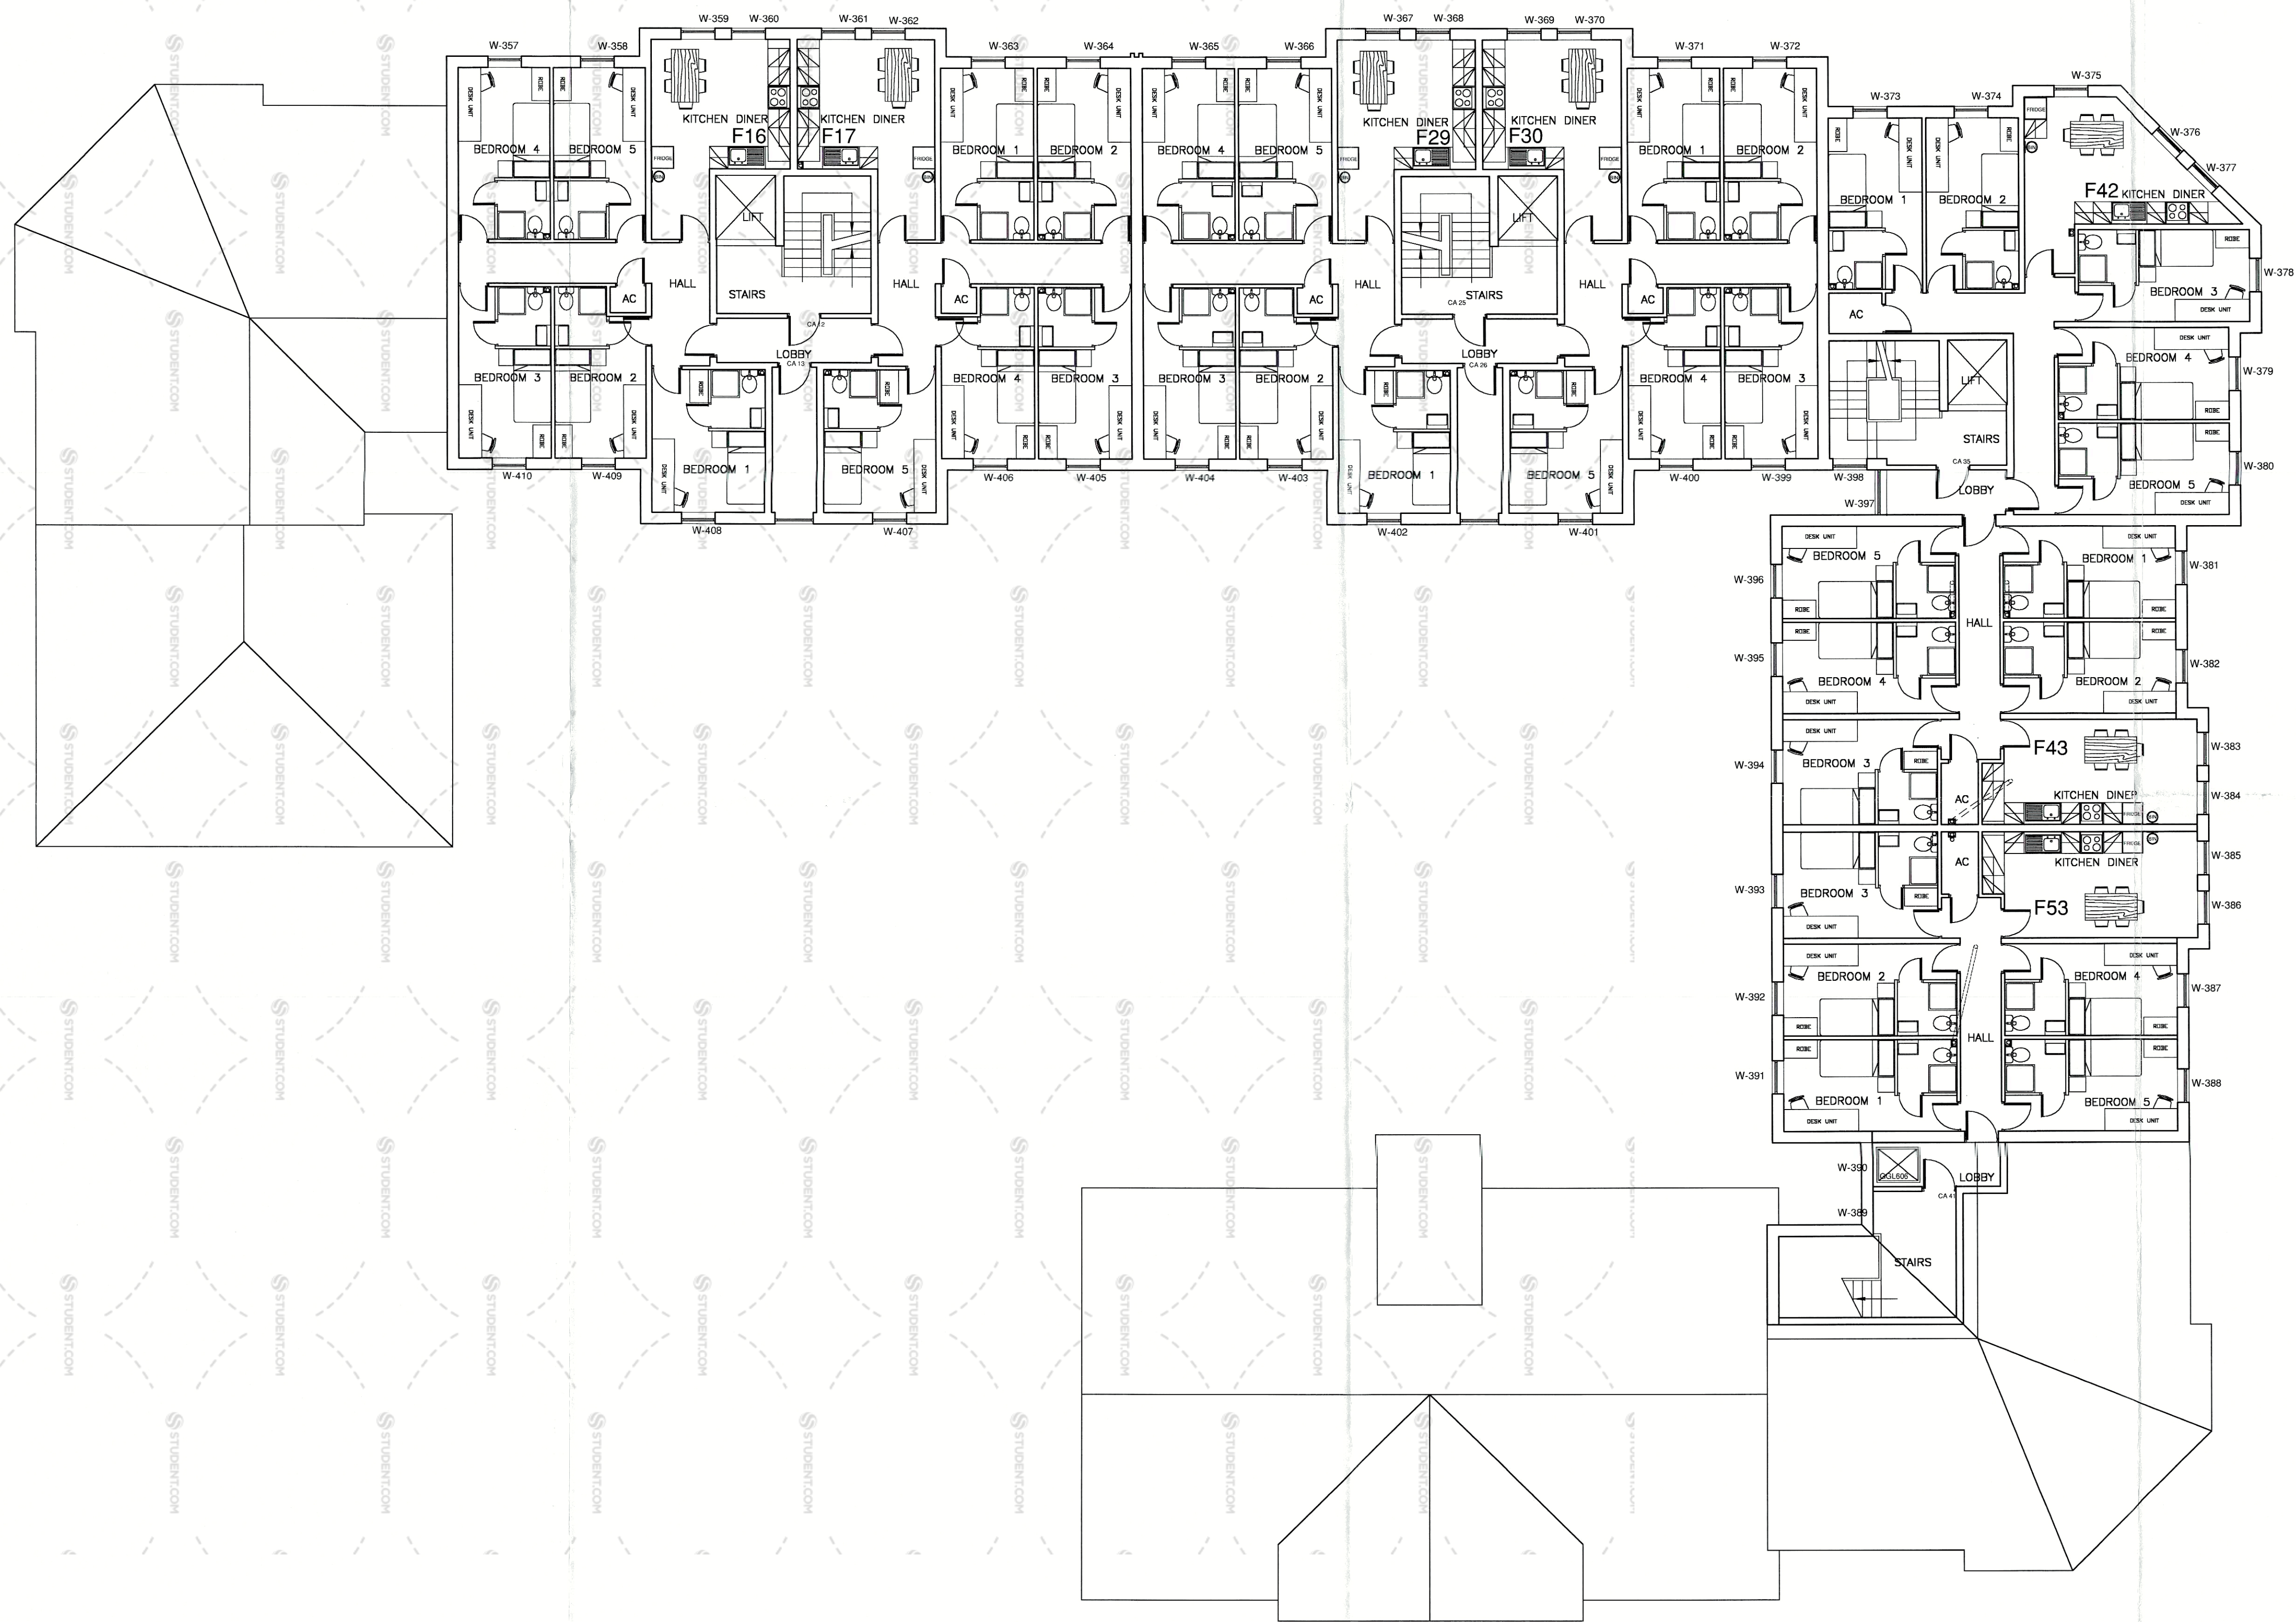

AS BUILT

**R.G+P.**

Richard Galey & Partners  
Architects, Interior Designers

The Old School, Loughborough Road  
Leicester, Leicestershire LE4 5PG  
Tel:(0116)2610333 Fax:(0116)2610678

Project PROPOSED STUDENT FLATS  
PARK STREET  
LINCOLN  
FOR  
RIVERSIDE DEVELOPMENTS LTD

Title FOURTH FLOOR PLAN  
GENERAL ARRANGEMENT

Scale 1:100 @ A1 Ref 5043/RD/205 G

Date 25.09.2000 Drawn MK

# FOURTH FLOOR PLAN

ALL DIMENSIONS TO BE CHECKED ON SITE. DO NOT SCALE OFF DRAWING.  
THIS DRAWING IS THE COPYRIGHT OF THE ARCHITECTS AND NOT TO BE REPRODUCED  
WITHOUT THEIR PERMISSION. QUANTITY SURVEY MAP INFORMATION INTRODUCED UPON  
PERMISSION OF BMMO CROWN COPYRIGHT RESERVED.