


Revisions	Date
A. NTL added, Lifts amended	23.11.00
B. Dimensions amended/added	08.11.00
C. Fire lobbies amended, dimensions removed	09.11.00
D. Door swings and 4 Windows amended for location to inner courtyard	25.11.2000
E. Information removed	30.1.01
F. Furniture and fittings amended	08.02.2001
G. Communications room added	08.04.2001
H. As built	18.09.2001

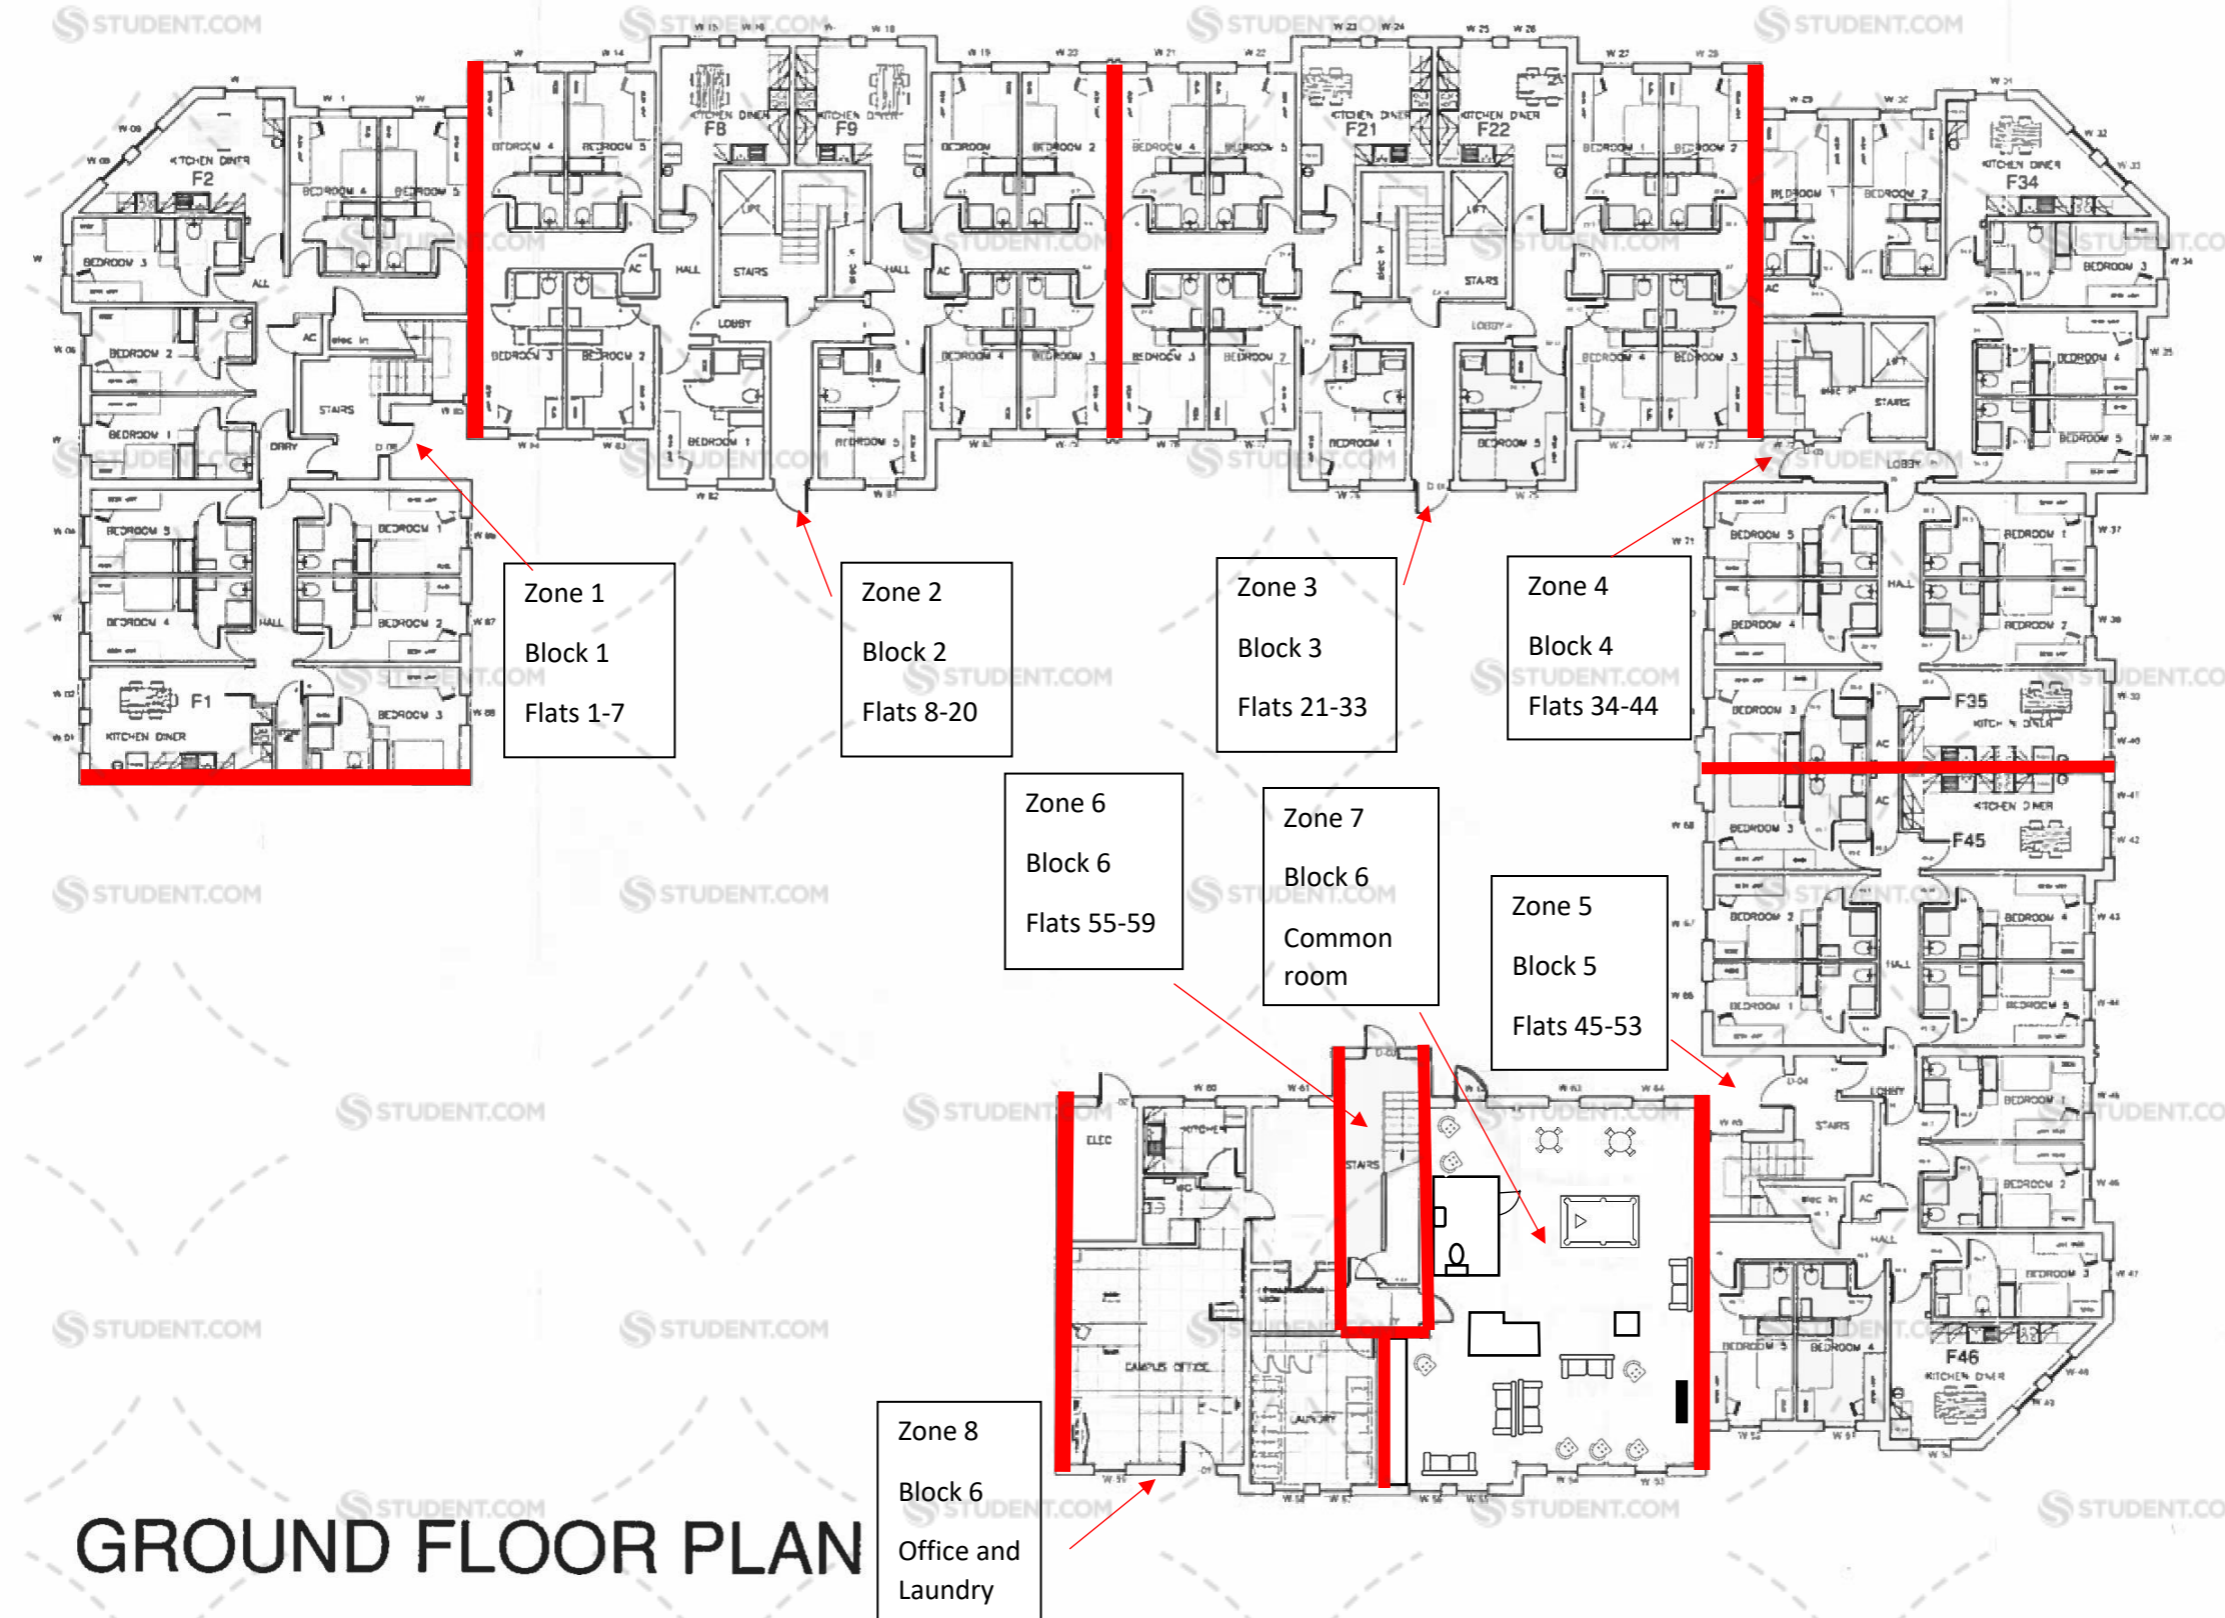

GROUND FLOOR PLAN

AS BUILT

R.G+P.

Richard Galey & Partners
Architects, Interior Designers
The Old School, Loughborough Road
Leicester, Leicestershire LE4 5PG
Tel:(0116)2610553 Fax:(0116)2610676

Project PROPOSED STUDENT FLAITS
PARK STREET
LINCOLN
FOR
RIVERSIDE DEVELOPMENTS LTD

Title GROUND FLOOR PLAN
GENERAL ARRANGEMENT
Scale 1:100 @ A1 Ref 5043/R0/201 H
Date 23.09.2000 Drawn MK

NO PART OF THIS DRAWING IS TO BE REPRODUCED OR TRANSMITTED IN ANY FORM OR BY ANY MEANS, ELECTRONIC OR MECHANICAL, WITHOUT THE WRITTEN PERMISSION OF THE ARCHITECTS. THE ARCHITECTS ACCEPT NO LIABILITY FOR ANY DAMAGE OR LOSS OF PROFITS OR BUSINESS ARISING FROM THE USE OF THIS DRAWING.