

NOTE:


Layer 'WW Site Dimensions 23.11.2017' shows the approximate location of existing brick buttresses and stone wall, to the north of the proposed Block A1, marked thus

Measurements were taken with a 3m tape measure, and roughly related to the steel columns of the former brewery structure which remain on site but these points are not to be relied on for setting out purposes.

This dimension check does clarify the survey points provided by BAM on 21/22 November to be either face of wall or face of buttress.

If MMOS Engineer's initial advice that these buttresses can come out, is borne out by further inspections then the proposed amendment to Block A1 - taking 90mm out between Grid 8a and 9A - appears to resolve the issue of incomplete and inaccurate survey information. Proposed relocated northern 'gable' wall of Block A1 is indicated thus.

BAM to survey the buttressed wall once access is provided by removal of the remaining steel structure and cladding and to provide to design team.

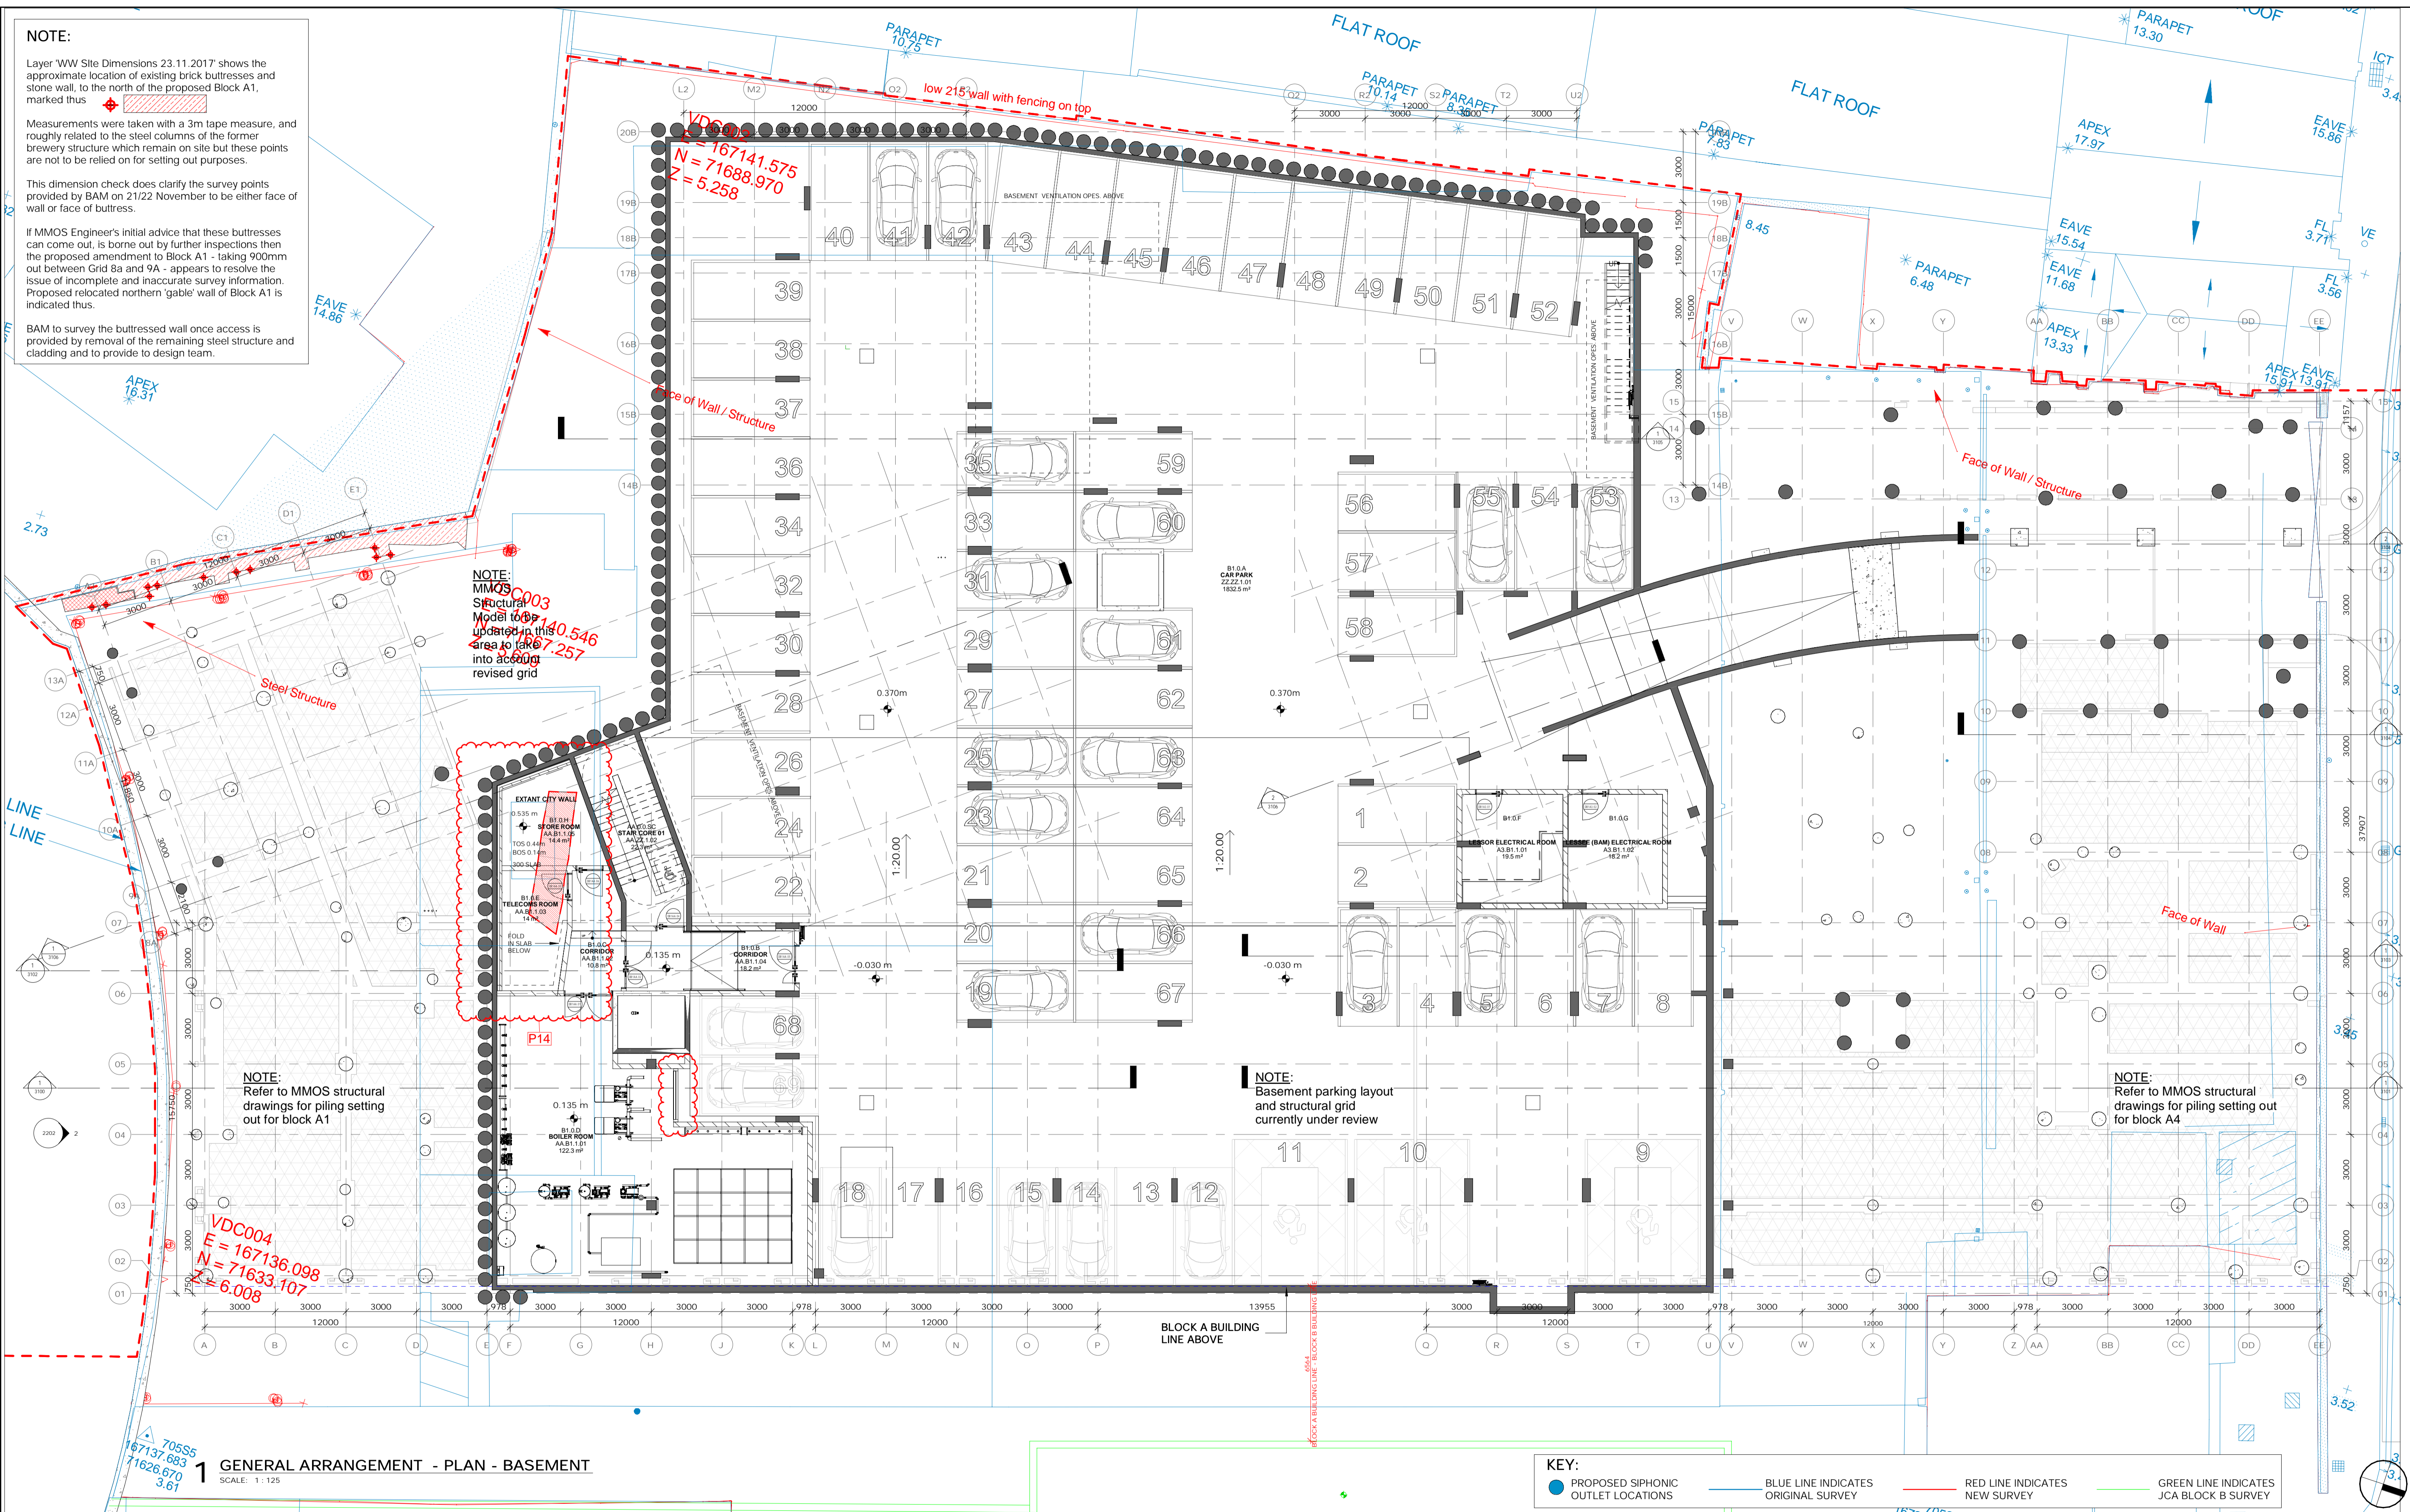

NOTE: Refer to MMOS structural drawings for piling setting out for block A1

NOTE: Basement parking layout and structural grid currently under review

NOTE: Refer to MMOS structural drawings for piling setting out for block A4

KEY:

- PROPOSED SIPHONIC OUTLET LOCATIONS
- BLUE LINE INDICATES ORIGINAL SURVEY
- RED LINE INDICATES NEW SURVEY
- GREEN LINE INDICATES JCA BLOCK B SURVEY

1 GENERAL ARRANGEMENT - PLAN - BASEMENT
SCALE: 1:125

COPYRIGHT. ALL RIGHTS RESERVED
This work is copyright and cannot be produced or copied in any form or by any means (graphic, electronic or mechanical including photocopying) without the written permission of the originator. Any license, express or implied, to use this document for any purpose whatsoever is restricted to the terms of the agreement or implied agreement between the originator and the instructing party.

This drawing is an extract from a BIM model.
Levels and contours are relative to a Survey.
Do not scale from this drawing. Work only from figured dimensions.
This drawing to be read in conjunction with relevant consultant's drawings.
This drawing includes information from the structural and services engineer's models.

NOTES:
LEVEL 2 STATUS CODES:
Work in Progress (Non-Contractual)
S0: Work in Progress

Shared (Non-Contractual)
S1: Suitable for Coordination
S2: Suitable for Information
S3: Suitable for Internal Review and Comment
S4: Suitable for Construction Approval
S6: Suitable for PIM Authorisation (Stages 2a, 2b and 3)
S7: Suitable for PIM Authorisation (Stages 4 and 5)

LEVEL 2 STATUS CODES CONTINUED:
D1: Suitable for Costing
D2: Suitable for Tender
D3: Suitable for Contractor Design
D4: Suitable for Manufacture / Procurement
AM: As Maintained

Published (Contractual)
A: Suitable for Construction
B: Partially Signed-off: For construction with comments
AB: As-Built Handover documentation

Description	Date	Issue
REVISED LAYOUT OF TELECOMS AND ADDITION OF STORE ROOM	12.08.2019	P14
SIGN BASE WAYFINDING-SIGNAGE PACKAGE FOR GSA+BAM	14.02.2019	P13
GSA ROOM NUMBERING ADDED & GENERAL UPDATE	01.11.2018	P12
REVISED BASEMENT DRAWING	22.10.2018	P11
BASEMENT PLAN ISSUED TO AECOM	15.10.2018	P10
NEW WINDOW TYPE ADDED A15 & CHANGES OF TYPES	10.10.2018	P9
UPDATED TAGS AND PARTITION WALLS	08.08.2018	P8
GENERAL UPDATE	25.05.2018	P7
GENERAL UPDATE	25.04.2018	P6


Scott Tallon Walker Architects
72 South Mall, Cork, Ireland

Tel: +353 (0)21 4320744
Fax: +353 (0)21 4961820
Email: cork@stwalkers.com
Web: www.stwalkers.com

Client: **BAM PROPERTY LTD.**
Project Name: **BREWERY QUARTER STUDENT ACCOMMODATION**
Project Address: **SOUTH MAIN ST., CORK**
Project Architect: **DAVID FLANNERY**

Drawing Name: **GEA - PLAN - BASEMENT**
Drawing No.: **BQSA-STW-ZZ-B1-DR-A-1100**
Drawing Scale: **As Indicated @ A1**
Drawing Status: **S3: SUITABLE FOR INTERNAL REVIEW AND COMMENT**
Project No.: **16030** Rev #: **P14**
Work Stage: **CONSTRUCTION** Date: **12.08.2019**
Package & Sheet Type: **GEA** Drawn: **KC**
Checked: **WW**

NOTE:

Layer 'WW Site Dimensions 23.11.2017' shows the approximate location of existing brick buttresses and stone wall, to the north of the proposed Block A1, marked thus 

Measurements were taken with a 3m tape measure, and roughly related to the steel columns of the former brewery structure which remain on site but these points are not to be relied on for setting out purposes.


This dimension check does clarify the survey points provided by BAM on 21/22 November to be either face of wall or face of buttress.

If MMOS Engineer's initial advice that these buttresses can come out, is borne out by further inspections then the proposed amendment to Block A1 - taking 90mm out between Grid 8a and 9A - appears to resolve the issue of incomplete and inaccurate survey information. Proposed relocated northern 'gable' wall of Block A1 is indicated thus.

BAM to survey the buttressed wall once access is provided by removal of the remaining steel structure and cladding and to provide to design team.

NOTE:



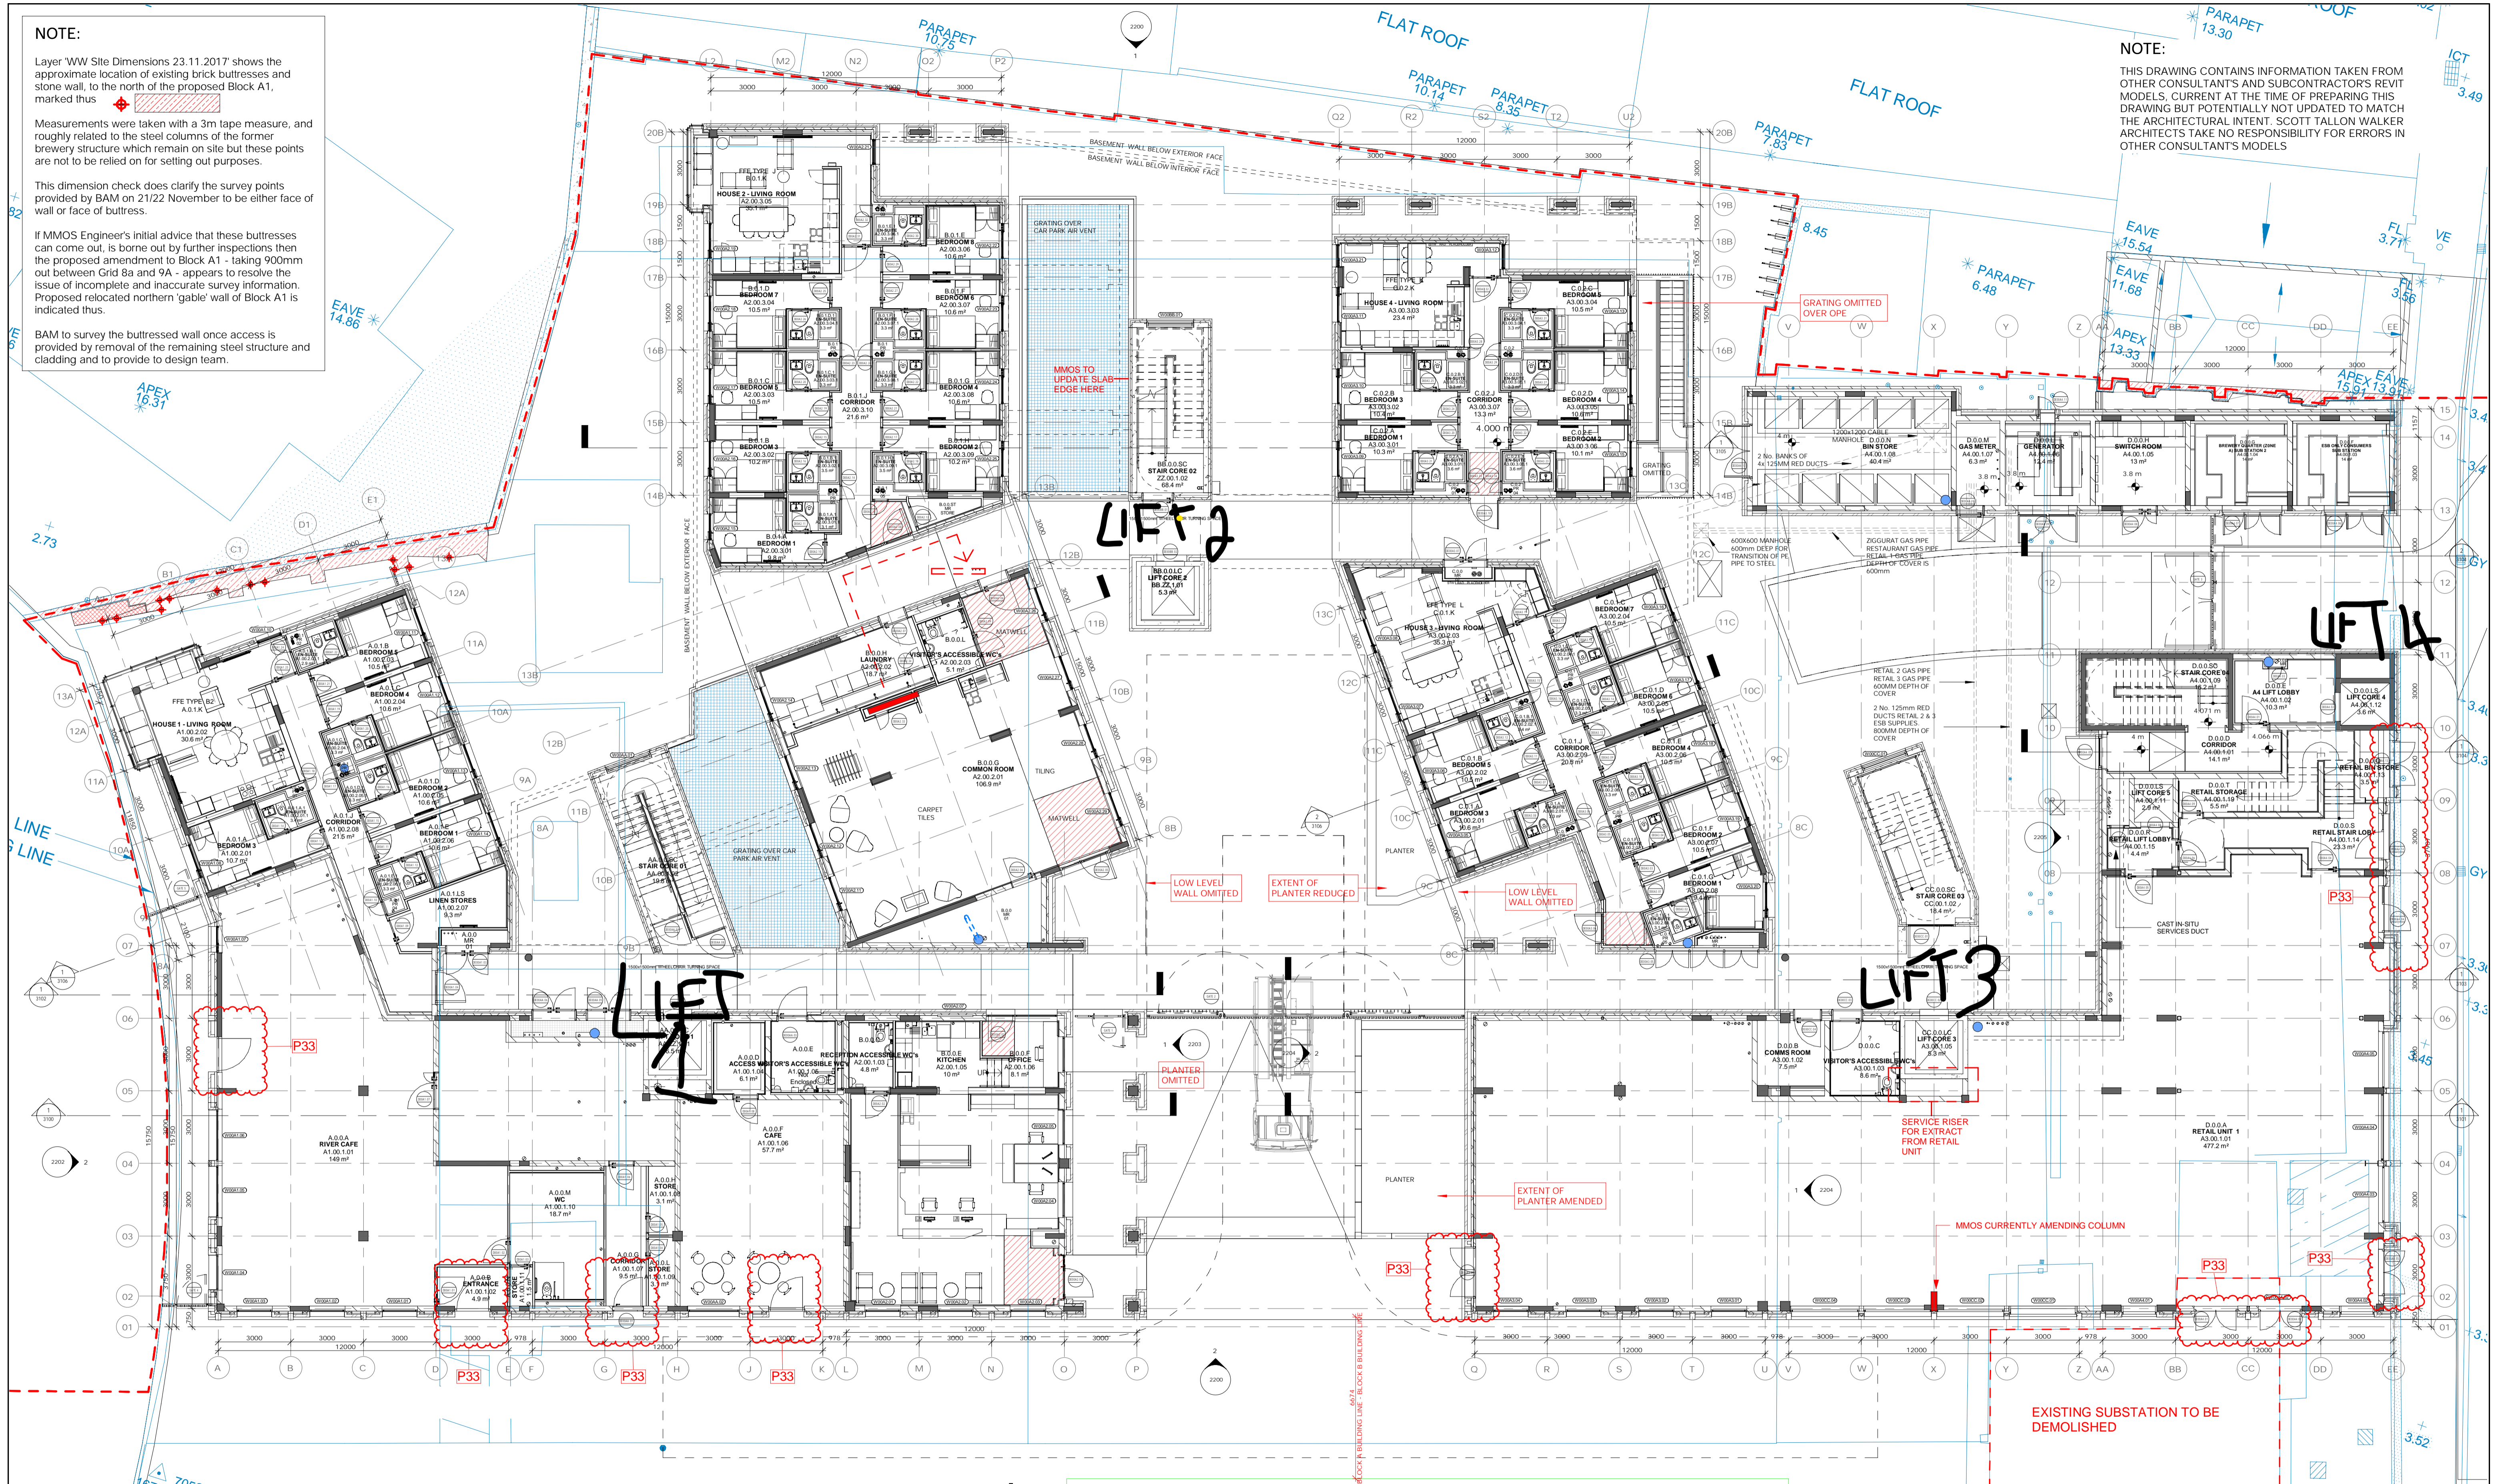

THIS DRAWING CONTAINS INFORMATION TAKEN FROM OTHER CONSULTANTS' AND SUBCONTRACTORS' REVIT MODELS. CURRENT AT THE TIME OF PREPARING THIS DRAWING BUT POTENTIALLY NOT UPDATED TO MATCH THE ARCHITECTURAL INTENT. SCOTT TALLON WALKER ARCHITECTS TAKE NO RESPONSIBILITY FOR ERRORS IN OTHER CONSULTANTS' MODELS.



1 GENERAL ARRANGEMENT - PLAN - GROUND FLOOR
SCALE: 1:125

NOTE: SYPHONIC DRAINAGE ROOF OUTLET LOCATIONS TO BE CONFIRMED ONCE CORRIDOR SERVICES RUNS ARE COMPLETED

KEY:

	PROPOSED SYPHONIC OUTLET LOCATIONS		BLUE LINE INDICATES ORIGINAL SURVEY		RED LINE INDICATES NEW SURVEY		GREEN LINE INDICATES JCA BLOCK B SURVEY
---	------------------------------------	---	-------------------------------------	---	-------------------------------	---	---

COPYRIGHT. ALL RIGHTS RESERVED
This work is copyright and cannot be produced or copied in any form or by any means (graphic, electronic or mechanical including photocopying) without the written permission of the originator. Any license, express or implied, to use this document for any purpose whatsoever is restricted to the terms of the agreement or implied agreement between the originator and the instructing party.

This drawing is an extract from a BIM model.
Levels and contours are relative to a Survey.
Do not scale from this drawing. Work only from figured dimensions.
This drawing to be read in conjunction with relevant consultant's drawings.
This drawing includes information from the structural and services engineer's models.

NOTES:

LEVEL 2 STATUS CODES:
W: Work In Progress (Non-Contractual)
S: Work In Progress

Shared (Non-Contractual)
S1: Suitable for Coordination
S2: Suitable for Information
S3: Suitable for Internal Review and Comment
S4: Suitable for Construction Approval
S6: Suitable for PIM Authorisation (Stages 2a, 2b and 3)
S7: Suitable for PIM Authorisation (Stages 4 and 5)

LEVEL 2 STATUS CODES CONTINUED:
D1: Suitable for Costing
D2: Suitable for Tender
D3: Suitable for Contractor Design
D4: Suitable for Manufacture / Procurement
AM: As Maintained

Published (Contractual)
A: Suitable for Construction
E: Partially Signed-off: For construction with comments
AB: As-Built Handover documentation

Description	Date	Issue
AMENDMENTS TO UPSTANDS AND FLOOD BARRIERS	03.10.2019	P33
AMENDMENT TO DOOR DE00AA.01	23.09.2019	P32
PLANTERS AND LOW SEATING WALLS OMITTED OR MODIFIED	18.09.2019	P31
REISSUE GEA FOR BAM SERVICES	2019.07.15	P30
UPDATED INTERNAL LAYOUT	24.06.2019	P29
UPDATED GA PLANS FOR STW INTERIORS	28.05.2019	P28
ISSUED TO STW INTERIOR DEPARTMENT	17.04.2019	P27
SIGN BASE WAYFINDING-SIGNAGE PACKAGE FOR GSA+BAM	14.02.2019	P26
REVISED GA PLANS	14.01.2019	P25

Scott Tallon Walker Architects
72 South Mall, Cork, Ireland

Tel: +353 (0)21 4320744
Fax: +353 (0)21 4961820
Email: cork@stwalkers.com
Web: www.stwalkers.com

Client: **BAM PROPERTY LTD.**
Project Name: **BREWERY QUARTER STUDENT ACCOMMODATION**
Project Address: **SOUTH MAIN ST., CORK**
Project Architect: **DAVID FLANNERY**

Drawing Name: **GEA - PLAN - GROUND FLOOR**
Drawing No.: **BQSA-STW-ZZ-00-DR-A-1101**
Drawing Scale: **As Indicated @ A1**
Drawing Status: **S3: SUITABLE FOR INTERNAL REVIEW AND COMMENT**
Project No.: **16030** Rev #: **P33**
Work Stage: **CONSTRUCTION** Date: **03.10.2019**
Package & Sheet Type: **Drawn: KC**
GEA **1000-1999: PLANS** Checked: **WW**

NOTE:

Layer 'WW Site Dimensions 23.11.2017' shows the approximate location of existing brick buttresses and stone wall, to the north of the proposed Block A1, marked thus

Measurements were taken with a 3m tape measure, and roughly related to the steel columns of the former brewery structure which remain on site but these points are not to be relied on for setting out purposes.

This dimension check does clarify the survey points provided by BAM on 21/22 November to be either face of wall or face of buttress.

If MMOS Engineer's initial advice that these buttresses can come out, it is borne out by further inspections then the proposed amendment to Block A1 - taking 90mm out between Grid 8a and 9A - appears to resolve the issue of incomplete and inaccurate survey information. Proposed relocated northern 'gable' wall of Block A1 is indicated thus.

BAM to survey the buttressed wall once access is provided by removal of the remaining steel structure and cladding and to provide to design team.



1 GENERAL ARRANGEMENT - PLAN - MEZZANINE

SCALE: 1:125

- KEY:**
- PROPOSED SIPHONIC OUTLET LOCATIONS (CapCon REVIEW DESIGN AND UPDATE ACCORDINGLY)
 - CapCon SIPHONIC DRAINAGE OUTLET.
 - FROM CURRENT CapCon REVIT MODEL
 - SOIL VENT PIPE LOCATION T.B.C. BY MBA

COPYRIGHT. ALL RIGHTS RESERVED
 This work is copyright and cannot be produced or copied in any form or by any means (graphic, electronic or mechanical including photocopying) without the written permission of the originator. Any license, express or implied, to use this document for any purpose whatsoever is restricted to the terms of the agreement or implied agreement between the originator and the instructing party.

This drawing is an extract from a BIM model.
 Levels and contours are relative to a Survey.
 Do not scale from this drawing. Work only from figured dimensions.
 This drawing to be read in conjunction with relevant consultant's drawings.
 This drawing includes information from the structural and services engineer's models.

NOTES:

LEVEL 2 STATUS CODES:	LEVEL 2 STATUS CODES CONTINUED:
S0: Work In Progress (Non-Contractual)	D1: Suitable for Costing
S1: Work In Progress	D2: Suitable for Tender
	D3: Suitable for Contractor Design
Shared (Non-Contractual)	D4: Suitable for Manufacturer / Procurement
S1: Suitable for Coordination	AM: As Maintained
S2: Suitable for Information	
S3: Suitable for Internal Review and Comment	Published (Contractual)
S4: Suitable for Construction Approval	A: Suitable for Construction
S5: Suitable for PIM Authorisation (Stages 2a, 2b and 3)	B: Partially Signed-off: For construction with comments
S6: Suitable for PIM Authorisation (Stages 4 and 5)	AB: As-Built Handover documentation.

UPDATED INTERNAL LAYOUT	24.06.2019	P23
SEE CLOUD FOR REVISION. GYM ENTRANCE	12.06.2019	P22
UPDATED GA PLANS FOR STW INTERIORS	28.05.2018	P21
ISSUED TO STW INTERIOR DEPARTMENT	17.04.2019	P20
WINDOW TAG ADDED IN GYM & DOOR TO MAINTENANCE ROOM	27.03.2019	P19
REVISED ROOF ACCESS PATHWAYS	25.03.2019	P18
UPDATED WINDOW G3 LOCATION	21.03.2019	P17
SIGN BASE WAYFINDING-SIGNAGE PACKAGE FOR GSA+BAM	14.02.2019	P16
REVISED GA PLANS	14.01.2019	P15
Description	Date	Issue


Scott Tallon Walker Architects
 72 South Mall, Cork, Ireland

Tel: +353 (0)21 4320744
 Fax: +353 (0)21 4961820
 Email: cork@stwalkers.com
 Web: www.stwalkers.com

Client: **BAM PROPERTY LTD.**
 Project Name: **BREWERY QUARTER STUDENT ACCOMMODATION**
 Project Address: **SOUTH MAIN ST., CORK**
 Project Architect: **DAVID FLANNERY**

Drawing Name: **GEA - PLAN - MEZZANINE**

Drawing No.: **BQSA-STW-ZZ-MO-DR-A-1102**
 Drawing Scale: **As indicated @ A1**
 Drawing Status: **S3: SUITABLE FOR INTERNAL REVIEW AND COMMENT**
 Project No.: **16030** Rev #: **P23**
 Work Stage: **CONSTRUCTION** Date: **24.06.2019**
 Package & Sheet Type: **Drawn: BF**
 GEA **1000-1999: PLANS** Checked: **WW**

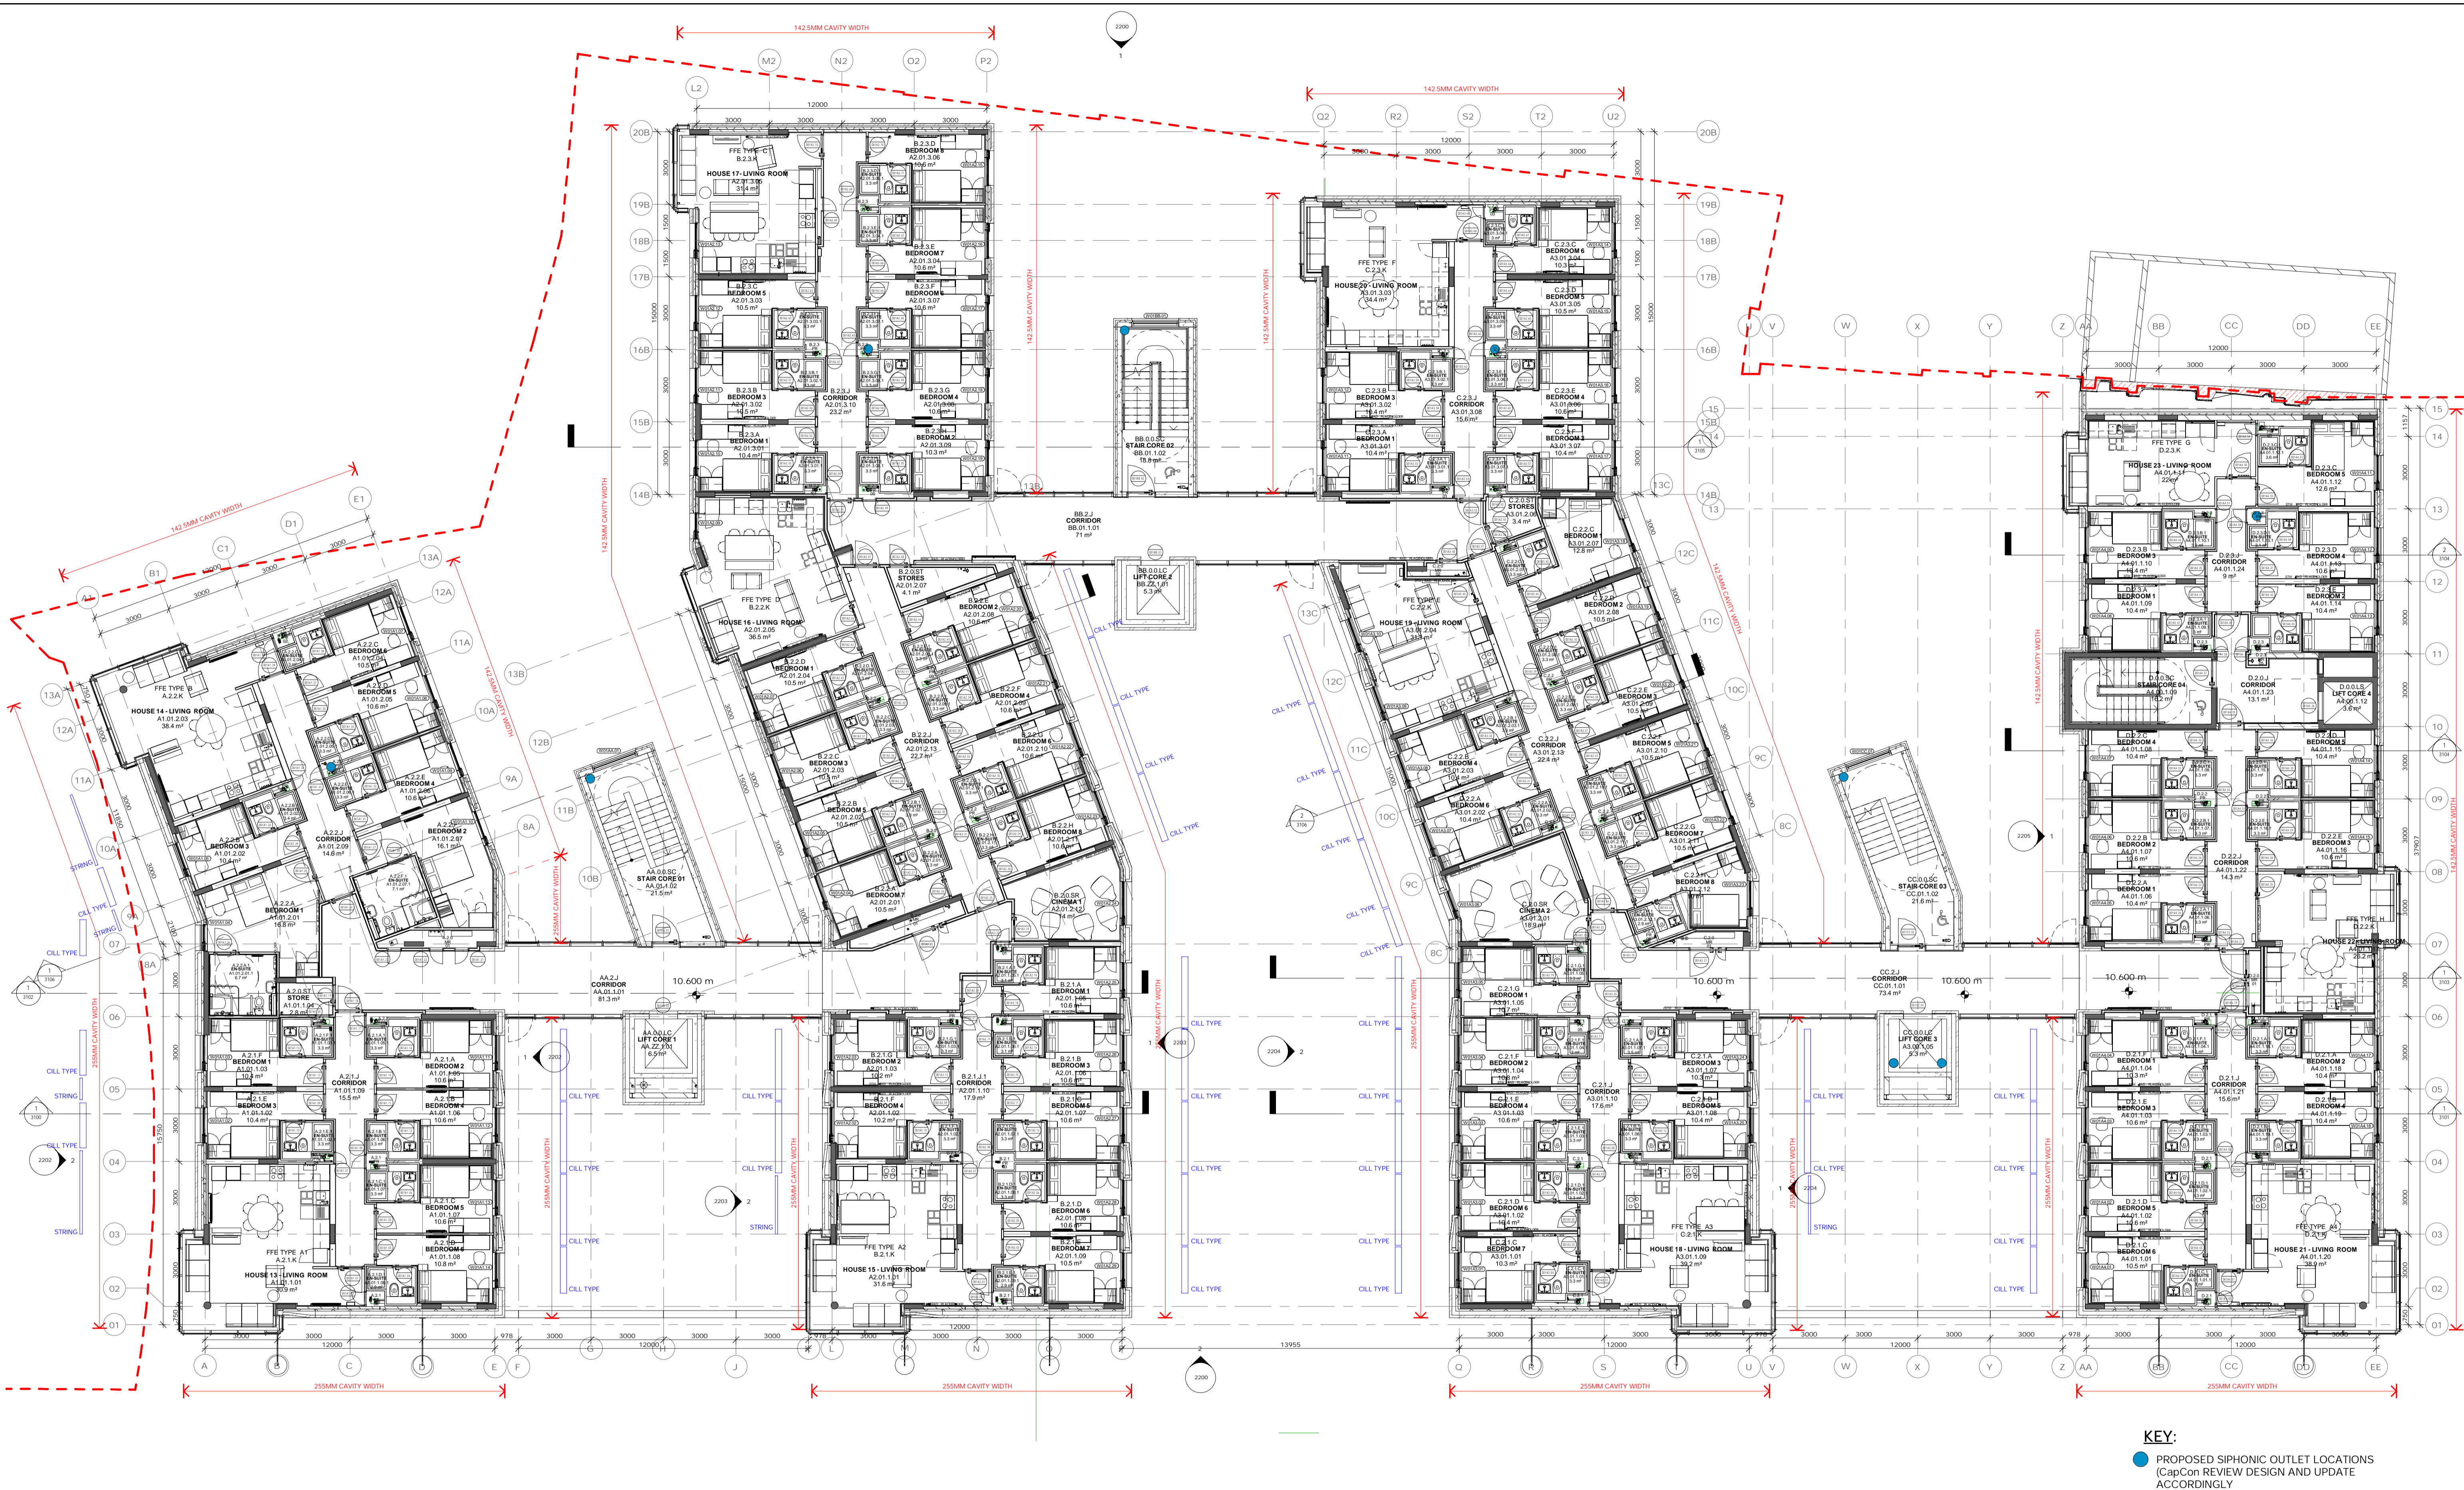

1 GENERAL ARRANGEMENT - PLAN - FIRST FLOOR
SCALE: 1:125

- KEY:**
- PROPOSED SIPHONIC OUTLET LOCATIONS (CapCon REVIEW DESIGN AND UPDATE ACCORDINGLY)
 - CapCon SIPHONIC DRAINAGE OUTLET FROM CURRENT CapCon REVIT MODEL
 - SOIL VENT PIPE LOCATION T.B.C. BY MBA

COPYRIGHT. ALL RIGHTS RESERVED
This work is copyright and cannot be produced or copied in any form or by any means (graphic, electronic or mechanical including photocopying) without the written permission of the originator. Any license, express or implied, to use this document for any purpose whatsoever is restricted to the terms of the agreement or implied agreement between the originator and the instructing party.

This drawing is an extract from a BIM model. Levels and contours are relative to a Survey. Do not scale from this drawing. Work only from figured dimensions. This drawing to be read in conjunction with relevant consultant's drawings. This drawing includes information from the structural and services engineer's models.

NOTES:
LEVEL 2 STATUS CODES:
Work In Progress (Non-Contractual)
S0: Work In Progress

Shared (Non-Contractual)
S1: Suitable for Coordination
S2: Suitable for Information
S3: Suitable for Internal Review and Comment
S4: Suitable for Construction Approval
S6: Suitable for PIM Authorisation (Stages 2a, 2b and 3)
S7: Suitable for PIM Authorisation (Stages 4 and 5)

LEVEL 2 STATUS CODES CONTINUED:
D1: Suitable for Costing
D2: Suitable for Tender
D3: Suitable for Contractor Design
D4: Suitable for Manufacture / Procurement
AM: As Maintained

Published (Contractual)
A: Suitable for Construction
E: Partially Signed-off: For construction with comments
AB: As-Built Handover documentation.

Description	Date	Issue
UPDATED GA PLANS FOR STW INTERIORS	28.05.2018	P18
ISSUED TO STW INTERIOR DEPARTMENT	17.04.2019	P17
SIGN BASE WAYFINDING-SIGNAGE PACKAGE FOR GSA+BAM	14.02.2019	P16
DRAFT NOTE REMOVED FROM GA PLAN	16.01.2019	P15
REVISED GA PLANS	14.01.2019	P14
ROOM NUMBERING REVIEW AND UPDATE	11.12.2018	P13
ADDED KITCHEN TYPE TAGS	12.11.2018	P12
GSA ROOM NUMBERING ADDED & GENERAL UPDATE	01.11.2018	P11
NEW WINDOW TYPE ADDED A15 & CHANGES OF TYPES	10.10.2018	P10

Scott Tallon Walker Architects
72 South Mall, Cork, Ireland

Tel: +353 (0)21 4320744
Fax: +353 (0)21 4961820
Email: cork@stwalkers.com
Web: www.stwalkers.com

Client: **BAM PROPERTY LTD.**
Project Name: **BREWERY QUARTER STUDENT ACCOMMODATION**
Project Address: **SOUTH MAIN ST., CORK**
Project Architect: **DAVID FLANNERY**

Drawing Name: **GEA - PLAN - FIRST FLOOR**

Drawing No.: **BOSA-STW-ZZ-01-DR-A-1103**
Drawing Scale: **As Indicated @ A1**
Drawing Status: **S3: SUITABLE FOR INTERNAL REVIEW AND COMMENT**
Project No.: **16030** Rev #: **P18**
Work Stage: **CONSTRUCTION** Date: **28.05.2018**
Package & Sheet Type: **GEA** Drawn: **GM**
Checked: **WV**



1 GENERAL ARRANGEMENT - PLAN - SECOND FLOOR
SCALE: 1:125

- KEY:**
- PROPOSED SIPHONIC OUTLET LOCATIONS (CapCon REVIEW DESIGN AND UPDATE ACCORDINGLY)
 - CapCon SIPHONIC DRAINAGE OUTLET FROM CURRENT CapCon REVIT MODEL
 - SOIL VENT PIPE LOCATION T.B.C. BY MBA

COPYRIGHT. ALL RIGHTS RESERVED
This work is copyright and cannot be produced or copied in any form or by any means (graphic, electronic or mechanical including photocopying) without the written permission of the originator. Any license, express or implied, to use this document for any purpose whatsoever is restricted to the terms of the agreement or implied agreement between the originator and the instructing party.

This drawing is an extract from a BIM model. Levels and contours are relative to a Survey. Do not scale from this drawing. Work only from figured dimensions. This drawing to be read in conjunction with relevant consultants' drawings. This drawing includes information from the structural and services engineer's models.

NOTES:
LEVEL 2 STATUS CODES:
W: Work In Progress (Non-Contractual)
S: Work In Progress

Shared (Non-Contractual)
S1: Suitable for Coordination
S2: Suitable for Information
S3: Suitable for Internal Review and Comment
S4: Suitable for Construction Approval
S6: Suitable for PIM Authorisation (Stages 2a, 2b and 3)
S7: Suitable for PIM Authorisation (Stages 4 and 5)

LEVEL 2 STATUS CODES CONTINUED:
D1: Suitable for Costing
D2: Suitable for Tender
D3: Suitable for Contractor Design
D4: Suitable for Manufacture / Procurement
AM: As Maintained

Published (Contractual)
A: Suitable for Construction
B: Partially Signed-off: For construction with comments
AB: As-Built Handover documentation.

Description	Date	Issue
DOOR TAG ADDED TO DOOR D02A3.71	16.09.2019	P16
UPDATED GA PLANS FOR STW INTERIORS	28.05.2018	P15
ISSUED TO STW INTERIOR DEPARTMENT	17.04.2019	P14
SIGN BASE WAYFINDING-SIGNAGE PACKAGE FOR GSA +BAM	14.02.2019	P13
REVISED GA PLANS	14.01.2019	P12
ROOM NUMBERING REVIEW AND UPDATE	11.12.2018	P11
ADDED KITCHEN TYPE TAGS	12.11.2018	P10
GSA ROOM NUMBERING ADDED & GENERAL UPDATE	01.11.2018	P9
NEW WINDOW TYPE ADDED A15 & CHANGES OF TYPES	10.10.2018	P8

Scott Tallon Walker Architects
72 South Mall, Cork, Ireland

Tel: +353 (0)21 4320744
Fax: +353 (0)21 4961820
Email: cork@stwalkers.com
Web: www.stwalkers.com

Client: **BAM PROPERTY LTD.**
Project Name: **BREWERY QUARTER STUDENT ACCOMMODATION**
Project Address: **SOUTH MAIN ST., CORK**
Project Architect: **DAVID FLANNERY**

Drawing Name: **GEA - PLAN - SECOND FLOOR**

Drawing No.: **BQSA-STW-ZZ-02-DR-A-1104**
Drawing Scale: **As Indicated @ A1**
Drawing Status: **S3: SUITABLE FOR INTERNAL REVIEW AND COMMENT**
Project No.: **16030** Rev #: **P16**
Work Stage: **CONSTRUCTION** Date: **16.09.2019**
Package & Sheet Type: **GEA** Drawn: **BF**
Checked: **WW**

1000-1999: PLANS



1 GENERAL ARRANGEMENT - PLAN - THIRD FLOOR

SCALE: 1:125

- KEY:**
- PROPOSED SIPHONIC OUTLET LOCATIONS (CapCon REVIEW DESIGN AND UPDATE ACCORDINGLY)
 - CapCon SIPHONIC DRAINAGE OUTLET FROM CURRENT CapCon REVIT MODEL
 - SOIL VENT PIPE LOCATION T.B.C. BY MBA

COPYRIGHT. ALL RIGHTS RESERVED
 This work is copyright and cannot be produced or copied in any form or by any means (graphic, electronic or mechanical including photocopying) without the written permission of the originator. Any license, express or implied, to use this document for any purpose whatsoever is restricted to the terms of the agreement or implied agreement between the originator and the instructing party.

This drawing is an extract from a BIM model.
 Levels and contours are relative to a Survey.
 Do not scale from this drawing. Work only from figured dimensions.
 This drawing to be read in conjunction with relevant consultant's drawings.
 This drawing includes information from the structural and services engineer's models.

NOTES:
LEVEL 2 STATUS CODES:
 Work In Progress (Non-Contractual)
 S0: Work In Progress

Shared (Non-Contractual)
 S1: Suitable for Coordination
 S2: Suitable for Information
 S3: Suitable for Internal Review and Comment
 S4: Suitable for Construction Approval
 S6: Suitable for PIM Authorisation (Stages 2a, 2b and 3)
 S7: Suitable for PIM Authorisation (Stages 4 and 5)

LEVEL 2 STATUS CODES CONTINUED:
 D1: Suitable for Costing
 D2: Suitable for Tender
 D3: Suitable for Contractor Design
 D4: Suitable for Manufacturer / Procurement
 AM: As Maintained

Published (Contractual)
 A: Suitable for Construction
 B: Partially Signed-off: For construction with comments
 AB: As-Built Handover documentation.

Description	Date	Issue
UPDATED GA PLANS FOR STW INTERIORS	28.05.2018	P20
ISSUED TO STW INTERIOR DEPARTMENT	17.04.2019	P19
KITCHEN TYPE P ADDED	02.04.2019	P18
REVISED LAYOUT OF HOUSES 44 & 54 DUE TO REQUIREMENTS OF FIRE OFFICER	27.03.2019	P17
REVISED ROOF ACCESS PATHWAYS	25.03.2019	P16
SIGN BASE WAYFINDING-SIGNAGE PACKAGE FOR GSA+BAM	14.02.2019	P15
REVISED GA PLANS	14.01.2019	P14
ROOM NUMBERING REVIEW AND UPDATE	11.12.2018	P13

Scott Tallon Walker Architects
 72 South Mall, Cork, Ireland

Tel: +353 (0)21 4320744
 Fax: +353 (0)21 4961820
 Email: cork@stwalkers.com
 Web: www.stwalkers.com

Client: **BAM PROPERTY LTD.**
 Project Name: **BREWERY QUARTER STUDENT ACCOMMODATION**
 Project Address: **SOUTH MAIN ST., CORK**
 Project Architect: **DAVID FLANNERY**

Drawing Name: **GEA - PLAN - THIRD FLOOR**

Drawing No.: **BQSA-STW-ZZ-03-DR-A-1105**
 Drawing Status: **As Indicated @ A1**
 Drawing Status: **S3: SUITABLE FOR INTERNAL REVIEW AND COMMENT**

Project No.: **16030** Rev #: **P20**
 Work Stage: **CONSTRUCTION** Date: **28.05.2018**
 Package & Sheet Type: **Drawn: BF**
 GEA **1000-1999: PLANS** Checked: **WW**



1 GENERAL ARRANGEMENT - PLAN - FOURTH FLOOR

SCALE: 1:125

- KEY:**
- PROPOSED SIPHONIC OUTLET LOCATIONS (CapCon REVIEW DESIGN AND UPDATE ACCORDINGLY)
 - CapCon SIPHONIC DRAINAGE OUTLET, FROM CURRENT CapCon REVIT MODEL
 - SOIL VENT PIPE LOCATION T.B.C. BY MBA

COPYRIGHT. ALL RIGHTS RESERVED
 This work is copyright and cannot be produced or copied in any form or by any means (graphic, electronic or mechanical including photocopying) without the written permission of the originator. Any license, express or implied, to use this document for any purpose whatsoever is restricted to the terms of the agreement or implied agreement between the originator and the instructing party.

This drawing is an extract from a BIM model. Levels and contours are relative to a Survey. Do not scale from this drawing. Work only from figured dimensions. This drawing to be read in conjunction with relevant consultant's drawings. This drawing includes information from the structural and services engineer's models.

NOTES:
LEVEL 2 STATUS CODES:
 Work In Progress (Non-Contractual)
 S0: Work In Progress

Shared (Non-Contractual)
 S1: Suitable for Coordination
 S2: Suitable for Information
 S3: Suitable for Internal Review and Comment
 S4: Suitable for Construction Approval
 S6: Suitable for PIM Authorisation (Stages 2a, 2b and 3)
 S7: Suitable for PIM Authorisation (Stages 4 and 5)

LEVEL 2 STATUS CODES CONTINUED:
 D1: Suitable for Costing
 D2: Suitable for Tender
 D3: Suitable for Contractor Design
 D4: Suitable for Manufacture / Procurement
 AM: As Maintained

Published (Contractual)
 A: Suitable for Construction
 B: Partially Signed-off: For construction with comments
 AB: As-Built Handover documentation.

Description	Date	Issue
ISSUED TO STW INTERIOR DEPARTMENT	17.04.2019	P16
REVISED LAYOUT OF HOUSES 44 & 54 DUE TO REQUIREMENTS OF FIRE OFFICER	27.03.2019	P15
SIGN BASE WAYFINDING-SIGNAGE PACKAGE FOR GSA+BAM	14.02.2019	P14
REVISED GA PLANS	14.01.2019	P13
ROOM NUMBERING REVIEW AND UPDATE. KITCHEN TYPE H2 ADDED TO BLOCK A4 FOURTH	11.12.2018	P12
ADDED KITCHEN TYPE TAGS	12.11.2018	P11
GSA ROOM NUMBERING ADDED & GENERAL UPDATE	01.11.2018	P10

Scott Tallon Walker Architects
 72 South Mall, Cork, Ireland

Tel: +353 (0)21 4320744
 Fax: +353 (0)21 4961820
 Email: cork@stwalkers.com
 Web: www.stwalkers.com

Client: **BAM PROPERTY LTD.**
 Project Name: **BREWERY QUARTER STUDENT ACCOMMODATION**
 Project Address: **SOUTH MAIN ST., CORK**
 Project Architect: **DAVID FLANNERY**

Drawing Name: **GEA - PLAN - FOURTH FLOOR**

Drawing No.: **BQSA-STW-ZZ-04-DR-A-1106**
 Drawing Scale: **As Indicated @ A1**
 Drawing Status: **S3: SUITABLE FOR INTERNAL REVIEW AND COMMENT**
 Project No.: **16030** Rev #: **P16**
 Work Stage: **CONSTRUCTION** Date: **17.04.2019**
 Package & Sheet Type: **Drawn: BF**
 GEA **1000-1999: PLANS** Checked: **WW**



1 GENERAL ARRANGEMENT - PLAN - FIFTH FLOOR
SCALE: 1 : 125

- KEY:**
- PROPOSED SIPHONIC OUTLET LOCATIONS (CapCon REVIEW DESIGN AND UPDATE ACCORDINGLY)
 - CapCon SIPHONIC DRAINAGE OUTLET FROM CURRENT CapCon REVIT MODEL
 - SOIL VENT PIPE LOCATION T.B.C. BY MBA

COPYRIGHT. ALL RIGHTS RESERVED
This work is copyright and cannot be produced or copied in any form or by any means (graphic, electronic or mechanical including photocopying) without the written permission of the originator. Any license, express or implied, to use this document for any purpose whatsoever is restricted to the terms of the agreement or implied agreement between the originator and the instructing party.

This drawing is an extract from a BIM model.
Levels and contours are relative to a Survey.
Do not scale from this drawing. Work only from figured dimensions.
This drawing to be read in conjunction with relevant consultant's drawings.
This drawing includes information from the structural and services engineer's models.

NOTES:
LEVEL 2 STATUS CODES:
Work In Progress (Non-Contractual)
S0: Work In Progress

Shared (Non-Contractual)
S1: Suitable for Coordination
S2: Suitable for Information
S3: Suitable for Internal Review and Comment
S4: Suitable for Construction Approval
S6: Suitable for PIM Authorisation (Stages 2a, 2b and 3)
S7: Suitable for PIM Authorisation (Stages 4 and 5)

LEVEL 2 STATUS CODES CONTINUED:
D1: Suitable for Costing
D2: Suitable for Tender
D3: Suitable for Contractor Design
D4: Suitable for Manufacture / Procurement
AM: As Maintained

Published (Contractual)
A: Suitable for Construction
B: Partially Signed-off: For construction with comments
AB: As-Built Handover documentation.

Description	Date	Issue
UPDATED INTERNAL LAYOUT	24.06.2019	P18
UPDATED GA PLANS FOR STW INTERIORS	28.05.2018	P17
ISSUED TO STW INTERIOR DEPARTMENT	17.04.2019	P16
REVISED ROOF ACCESS PATHWAYS	25.03.2019	P15
SIGN BASE WAYFINDING-SIGNAGE PACKAGE FOR GSA+ B&M	14.02.2019	P14
REVISED GA PLANS	14.01.2019	P13
ROOM NUMBERING REVIEW AND UPDATE	11.12.2018	P12
ADDED KITCHEN TYPE TAGS	12.11.2018	P11
GSA ROOM NUMBERING ADDED & GENERAL UPDATE	01.11.2018	P10

Scott Tallon Walker Architects
72 South Mall, Cork, Ireland

Tel: +353 (0)21 4320744
Fax: +353 (0)21 4961820
Email: cork@stwalkers.com
Web: www.stwalkers.com

Client: B&M PROPERTY LTD.
Project Name: BREWERY QUARTER STUDENT ACCOMMODATION
Project Address: SOUTH MAIN ST., CORK
Project Architect: DAVID FLANNERY

Drawing Name:
GEA - PLAN - FIFTH FLOOR

Drawing No.: BQSA-STW-ZZ-05-DR-A-1107
Drawing Scale: As indicated @ A1
Drawing Status: S3: SUITABLE FOR INTERNAL REVIEW AND COMMENT
Project No.: 16030 Rev #: P18
Work Stage: CONSTRUCTION Date: 24.06.2019
Package & Sheet Type: Drawn: BF
GEA 1000-1999-PLANS Checked: WW



1 GENERAL ARRANGEMENT - PLAN - SIXTH FLOOR
SCALE: 1 : 125

- KEY:**
- PROPOSED SIPHONIC OUTLET LOCATIONS (CapCon REVIEW DESIGN AND UPDATE ACCORDINGLY)
 - CapCon SIPHONIC DRAINAGE OUTLET FROM CURRENT CapCon REVIT MODEL
 - SOIL VENT PIPE LOCATION T.B.C. BY MBA

COPYRIGHT. ALL RIGHTS RESERVED
This work is copyright and cannot be produced or copied in any form or by any means (graphic, electronic or mechanical including photocopying) without the written permission of the originator. Any license, express or implied, to use this document for any purpose whatsoever is restricted to the terms of the agreement or implied agreement between the originator and the instructing party.

This drawing is an extract from a BIM model.
Levels and contours are relative to a Survey.
Do not scale from this drawing. Work only from figured dimensions.
This drawing to be read in conjunction with relevant consultant's drawings.
This drawing includes information from the structural and services engineer's models.

NOTES:
LEVEL 2 STATUS CODES:
Work In Progress (Non-Contractual)
S0: Work In Progress

LEVEL 2 STATUS CODES CONTINUED:
D1: Suitable for Costing
D2: Suitable for Tender
D3: Suitable for Contractor Design
D4: Suitable for Manufacture / Procurement
AM: As Maintained

Shared (Non-Contractual)
S1: Suitable for Coordination
S2: Suitable for Information
S3: Suitable for Internal Review and Comment
S4: Suitable for Construction Approval
S6: Suitable for PIM Authorisation (Stages 2a, 2b and 3)
S7: Suitable for PIM Authorisation (Stages 4 and 5)

Published (Contractual)
A: Suitable for Construction
B: Partially Signed-off: For construction with comments
AB: As-Built Handover documentation

Description	Date	Issue
UPDATED INTERNAL LAYOUT	24.06.2019	P17
UPDATED GA PLANS FOR STW INTERIORS	28.05.2018	P16
ISSUED TO STW INTERIOR DEPARTMENT	17.04.2019	P15
SIGN BASE WAYFINDING-SIGNAGE PACKAGE FOR GSA+BAM	14.02.2019	P14
REVISED GA PLANS	14.01.2019	P13
ROOM NUMBERING REVIEW AND UPDATE	11.12.2018	P12
ADDED KITCHEN TYPE TAGS	12.11.2018	P11
GSA ROOM NUMBERING ADDED & GENERAL UPDATE	01.11.2018	P10
NEW WINDOW TYPE ADDED A15 & CHANGES OF TYPES	10.10.2018	P9

Scott Tallon Walker Architects
72 South Mall, Cork, Ireland

Tel: +353 (0)21 4320744
Fax: +353 (0)21 4961820
Email: cork@stwalkers.com
Web: www.stwalkers.com

Client: **BAM PROPERTY LTD.**
Project Name: **BREWERY QUARTER STUDENT ACCOMMODATION**
Project Address: **SOUTH MAIN ST., CORK**
Project Architect: **DAVID FLANNERY**

Drawing Name:
GEA - PLAN - SIXTH FLOOR

Drawing No.: **BQSA-STW-ZZ-06-DR-A-1108**
Drawing Scale: **As Indicated @ A1**
Drawing Status: **S3: SUITABLE FOR INTERNAL REVIEW AND COMMENT**
Project No.: **16030** Rev #: **P17**
Work Stage: **CONSTRUCTION** Date: **24.06.2019**
Package & Sheet Type: **Drawn: BF**
GEA **1000-1999: PLANS** Checked: **WW**